

HARRISON  
 2047  
 5-22-79

MISSISSIPPI  
 BOARD OF WATER COMMISSIONERS  
 416 North State Street  
 Jackson, Mississippi 39201

WATER WELL DRILLERS LOG

5/22 1979 Duncan Well Drilling Harrison  
 date well completed firm name county well located

LANDOWNER: <u>Wilma Randall</u>	Description of formations encountered	from	to
<u>123 Hayden</u> <u>Pass Christian</u> (mailing address)			
WELL LOCATION: sec. <u>17</u> T. <u>2</u> N. R. <u>12</u> E. <u>1/2</u> miles <u>E</u> of <u>Pass Christian</u> (distance) (direction) (nearest town)	<u>sand</u>	<u>0</u>	<u>30</u>
WELL PURPOSE: <u>irrigation</u> (home, irrigation, municipal, industrial)			
WELL COMPLETION DATA: (1) diameter (inches) <u>2"</u> (2) total depth (feet) <u>30'</u> (3) static water level (feet) <u>6'</u> <u>below</u> top of ground. (4) casing <u>PVC</u> <u>20'</u> (material) (depth) — If telescope see back. (size) (5) screen <u>10'</u> <u>20'</u> (length) (depth to top) <u>2"</u> <u>PVC</u> (size) (material) (6) pump <u>1/2</u> <u>14</u> (HP) (yield gpm) <u>electric</u> (type power) (7) electric log _____ (yes or no) (organization running log) _____ (8) how well bottom plugged <u>Cap</u>			


DRILLERS REMARKS:

5 1979

RECEIVED

If well telescopes please sketch and show depths.

GROUND LEVEL

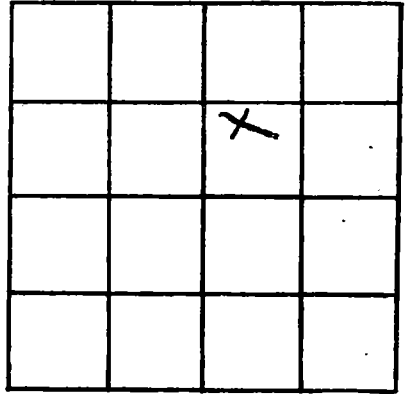

SECTION 17

Please indicate well location X.

ADDITIONAL INFORMATION

If more than one screen,  
show locations of each on sketch.