

HARRISON
Q 2053
12-15-79

MISSISSIPPI
 BOARD OF WATER COMMISSIONERS
 416 North State Street
 Jackson, Mississippi 39201

WATER WELL DRILLERS LOG

Dec. 15 1979 Duncan Well Drilling Harrison
 date well completed firm name county well located


LANDOWNER: <u>Jim Wise</u>	description of formations encountered	from	to
<u>Rt. 1 Box 105P</u>			
<u>Long Beach, Miss.</u> (mailing address)	<u>Sand Soil</u>	<u>0</u>	<u>23</u>
	<u>White Clay</u>	<u>23</u>	<u>210</u>
	<u>Fine Sand</u>	<u>210</u>	<u>235</u>
	<u>Blue Clay</u>	<u>235</u>	<u>544</u>
	<u>Fine Sand</u>	<u>544</u>	<u>580</u>
	<u>Course Sand</u>	<u>580</u>	<u>604</u>
WELL LOCATION: sec. <u>5</u> T. <u>8</u> N. <u>12</u> E. <u>3</u> miles <u>NW</u> of <u>Long Beach</u> (distance) (direction) (nearest town)			
WELL PURPOSE: <u>Home</u> (home, irrigation, municipal, industrial)			
WELL COMPLETION DATA: (1) diameter (inches) <u>2"</u> (2) total depth (feet) <u>604'</u> (3) static water level (feet) <u>16'</u> <u>below</u> top of ground (4) casing <u>PVC</u> , <u>594'</u> (material) (depth) <u>10'</u> If telescope see back. (size) (5) screen <u>10'</u> , <u>594'</u> (length) (depth to top) <u>2"</u> , <u>PVC</u> (size) (material) (6) pump <u>1</u> , <u>10</u> (HP) (yield gpm) <u>electric</u> (type power) (7) electric log _____ (yes or no) (organization running log) (8) how well bottom plugged <u>Sand</u> <u>Shank</u>			
DRILLERS REMARKS:			

DEPT. OF NATURAL RESOURCES
 BUREAU OF LAND & WATER RESOURCES

JAN 15 1980
 RECEIVED

If well telescopes please sketch and show depths.

GROUND LEVEL

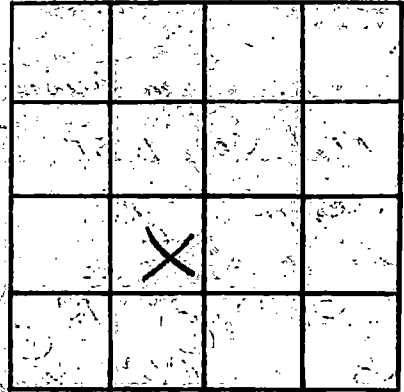

SECTION 5

Please indicate well location X:

ADDITIONAL INFORMATION

If more than one screen, show locations of each on sketch.