

MISSISSIPPI DEPARTMENT OF NATURAL RESOURCES

Bureau of Land and Water Resources

Southport Mall

P.O. Box 10631

Jackson, Mississippi 39209

WATER WELL DRILLERS LOG

HARRISON
Ø 2056
8-26-80

8-26 1980 Duncan Well Drilling Harrison
 date well completed firm name county well located

LANDOWNER Mark King Jr.
Rt. 2 Box 7W
Pass Christian, Ms. 39571
 (mailing address)

description of formations encountered	from	to
Sand	0	40
white clay	40	105
Blue Clay	105	278
fine sand	278	295
Coarse Grnd	295	310

WELL LOCATION:

sec 7 T 8 N R 12 E
1 1/2 miles N. of Pass Christian
 (distance) (direction) (nearest town)

WELL PURPOSE: Home
 (home, irrigation, municipal, industrial)

WELL COMPLETION DATA:

- diameter (inches) 2"
- total depth (feet) 310 ft.
- static water level (feet) 10' ^{below} _{above} top of ground.
- casing PVC, 310'
 (material) (depth)
 (size) If telescope see back.
- screen 10', 300'
 (length) (depth to top)
2", PVC
 (size) (material)
- pump electric (HP) (yield gpm)
 (type power)
- electric log (yes or no)

(organization running log)

(8) how well bottom plugged and
Mark

DRILLERS REMARKS: owner
installed pump


DEPT. OF NATURAL RESOURCES
 BUREAU OF LAND & WATER RESOURCES

OCT 31 1980

RECEIVED

If well telescopes please sketch and show depths.

GROUND LEVEL

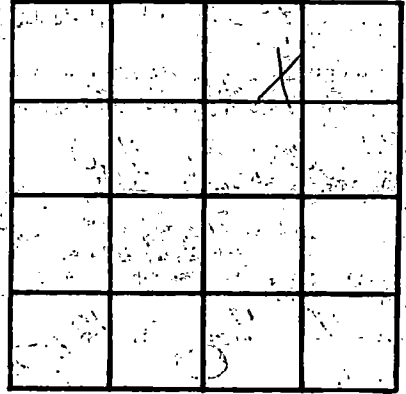

SECTION 1

Please indicate well location: X.

ADDITIONAL INFORMATION

If more than one screen, show locations of each on sketch.