

HARRISON
 2059
 9-22-80

MISSISSIPPI
 BOARD OF WATER COMMISSIONERS
 416 North State Street
 Jackson, Mississippi 39201

WATER WELL DRILLERS LOG

Sept. 22 1980 McNeil Well Works Harrison
 date well completed firm name county well located

LANDOWNER: Kenneth Smith
105 N. Oda Lane
Long Beach, Miss.
 (mailing address)

WELL LOCATION: 066 28th
 sec. 4 T. 8 N. R. 12 E.
3 miles N of Long Beach
 (distance) (direction) (nearest town)

WELL PURPOSE: home
 (home, irrigation, municipal, industrial)

WELL COMPLETION DATA:

- (1) diameter (inches) 2"
- (2) total depth (feet) 525'
- (3) static water level (feet) 10' ^{below} _{above} top of ground.
- (4) casing PVC, 515'
 (material), (depth)
- if telescope see back.
 (size)
- (5) screen 10', -
 (length), (depth to top)
2", plastic
 (size), (material)
- (6) pump 1, 18
 (HP), (yield gpm)
electric
 (type power)
- (7) electric log no
 (yes or no)
-
 (organization running log)
- (8) how well bottom plugged hard
stark

description of formations encountered	depth	
	from	to
<u>top soil</u>	<u>0</u>	<u>30</u>
<u>fine sand</u>	<u>30</u>	<u>90</u>
<u>mud</u>	<u>90</u>	<u>130</u>
<u>brn & mud</u>	<u>130</u>	<u>190</u>
<u>blue mud</u>	<u>190</u>	<u>230</u>
<u>white clay</u>	<u>230</u>	<u>275</u>
<u>f. sand</u>	<u>275</u>	<u>305</u>
<u>mud</u>	<u>305</u>	<u>400</u>
<u>sand mud</u>	<u>400</u>	<u>430</u>
<u>blue clay</u>	<u>430</u>	<u>480</u>
<u>lime sand</u>	<u>480</u>	<u>500</u>
<u>purple sand</u>	<u>500</u>	<u>525</u>

DEPT. OF NATURAL RESOURCES
 BUREAU OF LAND & WATER RESOURCES

SEP - 7 1987


RECEIVED

DRILLERS REMARKS:

If well telescopes please
sketch and show depths.

HARRISON
08-55-P

GROUND LEVEL

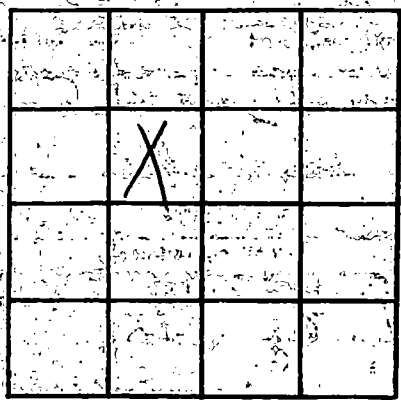

SECTION 4

Please indicate well location 'X'.

ADDITIONAL INFORMATION

If more than one screen,
show locations of each on sketch.