

MISSISSIPPI DEPARTMENT OF NATURAL RESOURCES

Bureau of Land and Water Resources

Southport Mall

P.O. Box 10631

Jackson, Mississippi 39209

WATER WELL DRILLERS LOG

HARRISON
0 2062
12/30/80

date well completed

firm name

county well located

12-30-1980 Duncan Well Drilling Harrison

LANDOWNER:

description of formations encountered

from

to

David Adams
Rt. 2 Box 18-D
Pass Christian, Ms.
 (mailing address)

sand 0 90
clay 90 385
clay + sand 385 450
blue clay 450 600
fine sand 600 650
course sand 650 672

WELL LOCATION:

sec 17 T 8 N R 12 E
3 miles SW of Long Beach
 (distance) (direction) (nearest town)

WELL PURPOSE:

(home, irrigation, municipal, industrial)

WELL COMPLETION DATA:

- (1) diameter (inches) 2"
- (2) total depth (feet) 672 ft.
- (3) static water level (feet) 15' ^{below} top of ground.
- (4) casing P.V.C. 662'
 (material) (depth)

(size) If telescope see back.

- (5) screen 10' 662'
 (length) (depth to top)
- 2" PVC
 (size) (material)

- (6) pump 1/6 HP 16
 (type power) (yield gpm)

- (7) electric log electric
 (yes or no)

(organization running log)

- (8) how well bottom plugged sand
hard

DRILLERS REMARKS:


DEPT. OF NATURAL RESOURCES
 BUREAU OF LAND & WATER RESOURCES

MAR 18 1981

RECEIVED

If well telescopes please sketch and show depths.

GROUND LEVEL

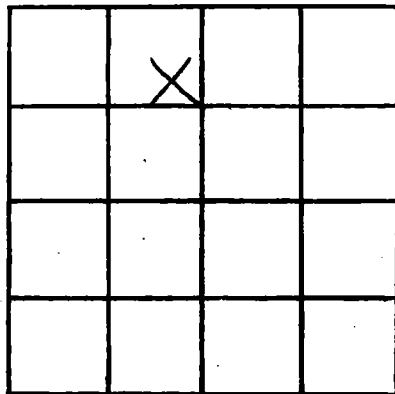

SECTION 17

Please indicate well location X.

ADDITIONAL INFORMATION

If more than one screen,
show locations of each on sketch.