

MISSISSIPPI DEPARTMENT OF NATURAL RESOURCES

Bureau of Land and Water Resources

Southport Mall

P.O. Box 10631

Jackson, Mississippi 39209

WATER WELL DRILLERS LOG

HARRISON
D 2064
2/4/81

date well completed

firm name

county well located

1981 Harrison Well Drilling Harrison

LANDOWNER: Bobby McClelland

Description of formations encountered

from to

127 Troutman Ave
Long Beach Ms. 39501
(mailing address)

Clay	0	17
sand	17	40
Blue clay	40	210
sand	210	225
Blue clay	225	380
fine sand	380	405
Course Sand	405	430

WELL LOCATION:

sec 8 N R 12 E
5 miles NW of Long Beach
(distance) (direction) (nearest town)

WELL PURPOSE: home
(home, irrigation, municipal, industrial)

WELL COMPLETION DATA:

- diameter (inches) 4.30"
- total depth (feet) 420'
- static water level (feet) 25' ^{below} above top of ground.
- casing PVC 420'
(material) (depth)
(size) if telescope see back.
- screen 10' 420'
(length) (depth to top)
2" PVC
(size) (material)
- pump 1 15
(HP) (yield gpm)
electric
(type power)
- electric log (yes or no)

(organization running log)

(8) how well bottom plugged Sand
Shark

DRILLERS REMARKS:


DEPT. OF NATURAL RESOURCES
BUREAU OF LAND & WATER RESOURCES

MAR 18 1981

RECEIVED

If well telescopes please sketch and show depths.

GROUND LEVEL

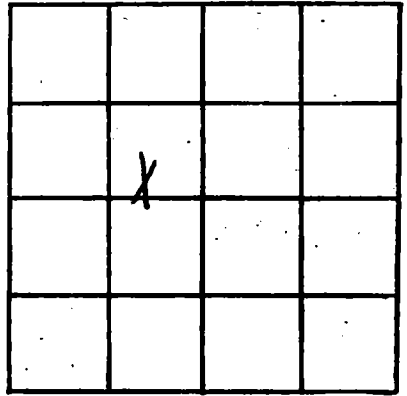

SECTION 33

Please indicate well location X.

ADDITIONAL INFORMATION

If more than one screen, show locations of each on sketch.