

MISSISSIPPI DEPARTMENT OF NATURAL RESOURCES

Bureau of Land and Water Resources

Southport Mall

P.O. Box 10631

Jackson, Mississippi 39209

WATER WELL DRILLERS LOG

HARRISON  
 2065  
 2/10/81

Feb. 10 1981  
 date well completed

81. Nunan Well Drilling  
 firm name

Harrison  
 county well located

LANDOWNER: Derothy Price

1307 E. Beach

Pass Christian

(mailing address)

WELL LOCATION:

sec. 7 T. 8 R. 12  
 (distance) (direction) (nearest town)

WELL PURPOSE: house  
 (home, irrigation, municipal, industrial)

WELL COMPLETION DATA:

- (1) diameter (inches) 2"
- (2) total depth (feet) 520'
- (3) static water level (feet) 10' below above  
top of ground.
- (4) casing PVC 510'  
(material) (depth)
- (5) screen 10' 510'  
(length) (depth to top)
- 2" PVC  
(size) (material)
- (6) pump \_\_\_\_\_ (HP) \_\_\_\_\_ (yield gpm)
- (type power) \_\_\_\_\_
- (7) electric log \_\_\_\_\_ (yes or no)
- (organization running log) \_\_\_\_\_

(8) how well bottom plugged hard  
Sharp

DRILLERS REMARKS: Owner  
install own  
ump

description of formations encountered

from to

Clay	0	10
Sand	10	57
Blue Clay	57	213
Sand	213	230
Blue Clay	230	310
Sand	310	330
B. Clay	330	415
Sand	415	440
Blue Clay	440	460
fine sand	460	490
Course	490	520


DEPT. OF NATURAL RESOURCES  
 BUREAU OF LAND & WATER RESOURCES

MAR 18 1981

RECEIVED

If well telescopes please sketch and show depths.

GROUND LEVEL

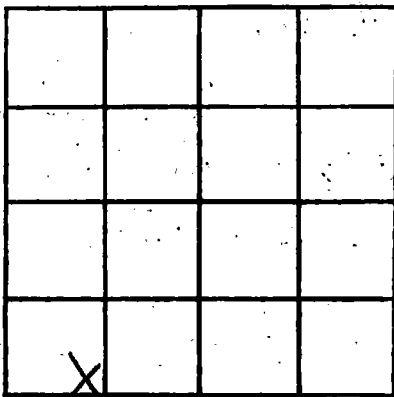

SECTION 7

Please indicate well location X.

ADDITIONAL INFORMATION

If more than one screen, show locations of each on sketch.