

MISSISSIPPI DEPARTMENT OF NATURAL RESOURCES

Bureau of Land and Water Resources

Southport Mall

P.O. Box 10631

Jackson, Mississippi 39209

WATER WELL DRILLERS LOG

HARRISON  
Q 2066  
2/10/81

date well completed

firm name

county well located

1981 Duncan Well Drilling Harrison

LANDOWNER: Norothy Prince  
1307 E. Beach  
Pass Christian Ms  
(mailing address) 1

WELL LOCATION:  
sec. 7 T. 8 N. R. 12 E.  
On Pineville  
(distance) miles (direction) (nearest town)

WELL PURPOSE: house  
(home, irrigation, municipal, industrial)

WELL COMPLETION DATA:

- (1) diameter (inches) 504'
- (2) total depth (feet) 211
- (3) static water level (feet) 6' below above top of ground.
- (4) casing PVC, 494  
(material) (depth)
- (5) screen 10', 494  
(length) (depth to top)  
2", PVC  
(size) (material)
- (6) pump 1, 20  
(HP) (yield gpm)  
electric  
(type power)
- (7) electric log (yes or no) \_\_\_\_\_

(organization running log) \_\_\_\_\_

(8) how well bottom plugged? Sand  
Shale

Description of formations encountered	from	to
Clay	0	10
Sand	10	57
Blue Clay	57	213
Sand	213	230
Blue Clay	230	310
Sand	310	330
Blue Clay	330	415
Sand	415	440
Blue Clay	440	460
fine Sand	460	490
Course	490	504

DEPT. OF NATURAL RESOURCES  
BUREAU OF LAND & WATER RESOURCES


MAR 18 1981

RECEIVED

DRILLERS REMARKS: \_\_\_\_\_

If well telescopes please sketch and show depths.

GROUND LEVEL

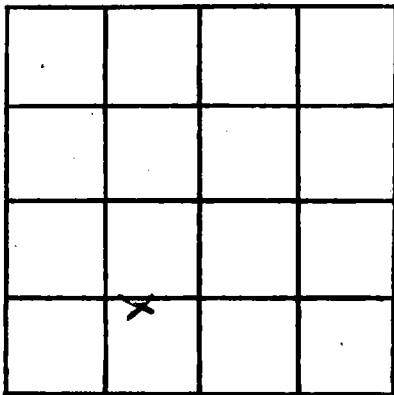

SECTION 7

Please indicate well location X.

ADDITIONAL INFORMATION

If more than one screen, show locations of each on sketch.