

MISSISSIPPI DEPARTMENT OF NATURAL RESOURCES

Bureau of Land and Water Resources

Southport Mall

P.O. Box 10631

Jackson, Mississippi 39209

WATER WELL DRILLERS LOG

HARRISON
 2269
 4/10/81

April 10 1981 date well completed
 81 Duncan Well Drilling firm name
 Harrison county well located

LANDOWNER: Bruce Owens
 Gay Road
 Long Beach, Mo.
 (mailing address)

description of formations encountered	from	to
tan sand	0	35
white clay	35	90
blue clay	90	220
fine sand	220	243
blue clay	243	380
fine sand	380	415
coarse sand	415	441

WELL LOCATION:
 sec. 12 T-8 N R-12 E
 In city of Long Beach
 (distance) (direction) (nearest town)

WELL PURPOSE: Home
 (home, irrigation, municipal, industrial)

WELL COMPLETION DATA:


- (1) diameter (inches) 2"
- (2) total depth (feet) 441 ft.
- (3) static water level (feet) 12" below top of ground.
- (4) casing PVC 431' (material) (depth)
- (5) screen 10' 431' (length) (depth to top)
 2" PVC (size) (material)
- (6) pump (HP) (yield gpm)
 (type power)
- (7) electric log (yes or no)
 (organization running log)
- (8) how well bottom plugged Sand
 sharp

DRILLERS REMARKS: Owner installed his own pump

DEPT. OF NATURAL RESOURCES
 BUREAU OF LAND & WATER RESOURCES
 MAY 18 1981
 RECEIVED

If well telescopes please sketch and show depths.

GROUND LEVEL

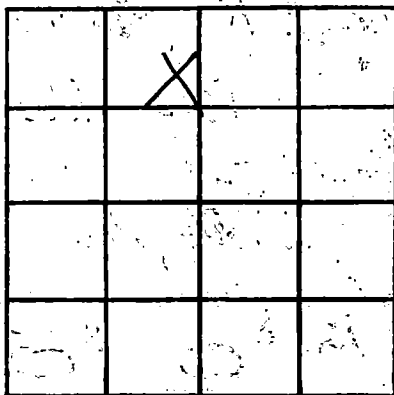

SECTION 12

Please indicate well location X.

ADDITIONAL INFORMATION

If more than one screen,
show locations of each on sketch.