

MISSISSIPPI DEPARTMENT OF NATURAL RESOURCES

Bureau of Land and Water Resources

Southport Mall

P.O. Box 10631

Jackson, Mississippi 39209

WATER WELL DRILLERS LOG

BRADEN PUMP AND WELL SERVICE, INC.

ROUTE 1, BOX 489

SAUCIER, MS 39574

county well located

HARRISON  
 2070  
 8-8-81

8-8-81

date well completed

19

HARRISON

LANDOWNER:  
 FRANK LOPRESTO  
 P.O. Box 106  
 Long Beach, MS  
 (mailing address)

description of formations encountered	from	to
CLAY	0	10
SAND	10	20
CLAY	20	45
SAND	45	50
CLAY	50	60
SAND	60	70
CLAY	70	155
SAND	155	160
CLAY	160	213
SAND	213	240

WELL LOCATION:  
 sec. 1 T. 8 N. R. 12 E.  
 in        miles Long Beach of        (nearest town)  
 (distance) (direction)

WELL PURPOSE: home  
 (home, irrigation, municipal, industrial)

- WELL COMPLETION DATA:
- (1) diameter (inches) 2"
  - (2) total depth (feet) 240'
  - (3) static water level (feet) 15 below above top of ground.
  - (4) casing PVC total  
 (material) (depth)
  - 2 1/2"  
 (size) If telescope see back.
  - (5) screen 10 230  
 (length) (depth to top)
  - 2" PVC underbar  
 (size) (material)
  - (6) pump 1 10  
 (HP) (yield gpm)
  - 110  
 (type power)
  - (7) electric log NO  
 (yes or no)
  - (organization running log)
  - (8) how well bottom plugged 2 1/2" SAND SHARK



DRILLERS REMARKS:  
NO TAIL PIPE

DEPT. OF NATURAL RESOURCES  
 BUREAU OF LAND & WATER RESOURCES

AUG 25 1981

If well telescopes please sketch and show depths.


GROUND LEVEL

X			

SECTION 1

Please indicate well location X.

ADDITIONAL INFORMATION

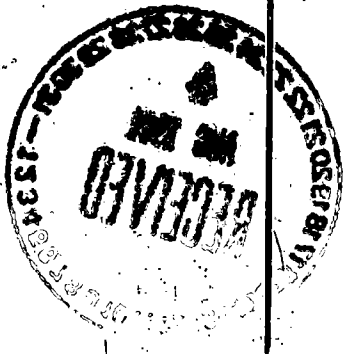

If more than one screen, show locations of each on sketch.