

MISSISSIPPI DEPARTMENT OF NATURAL RESOURCES

Bureau of Land and Water Resources

Southport Mall

P.O. Box 10631

Jackson, Mississippi 39209

WATER WELL DRILLERS LOG

COASTAL DRILLING & SERVICE CO.

HARRISON
 # 2071
 8/26/81

8/26/81
 date well completed

ROUTE 1 BOX 618
 film name

Harrison
 county well located

BILOXI, MISS. 39532

LANDOWNER: Joe Starnes
pinewill road
poor Chinton
 (mailing address)

description of formations encountered	from	to
top soil	1	3
red clay	3	15
gray sand	15	70
coarse white sand	70	140
soft blue clay	140	210
fine white sand	210	240
hard blue clay	240	530
fine white sand	530	600
good water sand	560	615


WELL LOCATION:
 sec. S T. S N. R. 2 E.
Chilton
 (distance) miles (direction) of (nearest town)

WELL PURPOSE: home
 (home, irrigation, municipal, industrial)

WELL COMPLETION DATA:
 (1) diameter (inches) 4 1/2"
 (2) total depth (feet) 615'
 (3) static water level (feet) 10' below above top of ground.
 (4) casing PK (material) 600' (depth)
4 1/2" (size) if telescope see back.
 (5) screen 15' (length) 600' (depth to top)
2" (size) PK (material)
 (6) pump Dwell (HP) 20 (yield gpm)
5hp (type power)
 (7) electric log no (yes or no)
 (organization running log)

(8) how well bottom plugged
2' fresh water value

DRILLERS REMARKS: none

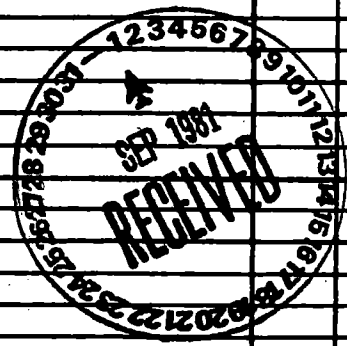

If well telescopes please sketch and show depths.


GROUND LEVEL

160' 4" pd Casing

440' 2" pd Casing

15' 3" pd Screen

2 feet well Valve

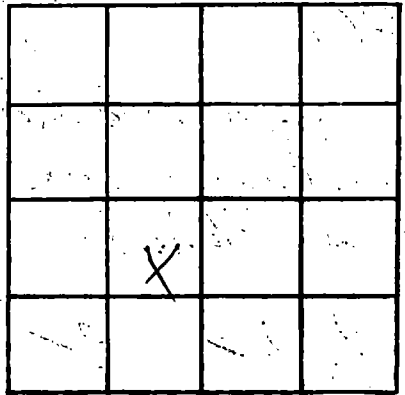

SECTION _____

Please indicate well location X.

ADDITIONAL INFORMATION

If more than one screen, show locations of each on sketch.