

MISSISSIPPI DEPARTMENT OF NATURAL RESOURCES

Bureau of Land and Water Resources

Southport Mall

P.O. Box 10631

Jackson, Mississippi 39209

WATER WELL DRILLERS LOG

**HARRISON**  
~~00~~ 2072  
 8-4-81

Aug. 4 1981  
 date well completed

Muncie Well Drilling Harrison  
 firm name

county well located

LANDOWNER: V.E. Phelps  
Rt. 2 Box 7 E  
Pass Christian  
 (mailing address)

description of formations encountered	from	to
clay + sand mixed	0	100
white clay	100	210
fine sandy	210	300
coarse sand	300	325

WELL LOCATION:  
 sec. 12 T. 8 N. R. 12 E  
3 miles N.E. of Greenville  
 (distance) (direction) (nearest town)

WELL PURPOSE: Home  
 (home, irrigation, municipal, industrial)

- WELL COMPLETION DATA:
- (1) diameter (inches) 2"
  - (2) total depth (feet) 325'
  - (3) static water level (feet) 4' below top of ground
  - (4) casing pvc 315'  
 (material) (depth)
  - (size) 10 if telescope see back.
  - (5) screen 10 315'  
 (length) (depth to top)
  - (size) 2" (material) pvc
  - (6) pump 1 12  
 (HP) (yield gpm)
  - (type power) electric
  - (7) electric log ---  
 (yes or no)

(organization running log)  
 (8) how well bottom plugged sand  
shuck


DRILLERS REMARKS:

DEPT. OF NATURAL RESOURCES  
 BUREAU OF LAND & WATER RESOURCES

OCT 19 1981  
**RECEIVED**

If well telescopes please sketch and show depths.

GROUND LEVEL.

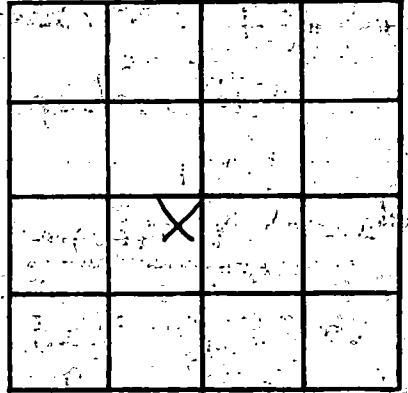

SECTION 12

Please indicate well location X.

**ADDITIONAL INFORMATION**

If more than one screen, show locations of each on sketch.