

MISSISSIPPI DEPARTMENT OF NATURAL RESOURCES

Bureau of Land and Water Resources

Southport Mall

P.O. Box 10631

Jackson, Mississippi 39209

WATER WELL DRILLERS LOG

HARRISON
 2074
 10-6-81

Oct. 6 1981
 date well completed

81 Dincom Well Drilling
 firm name

Harrison
 county well located

LANDOWNER Otto Hartwig
Rt. 2 Box 4
Pass Christian
 (mailing address)

description of formations encountered	from	to
Clay + Sand mixed	0	100
Blue Clay	100	180
Fine sand	186	240
Coarse	210	240

WELL LOCATION:
 sec. 12 T. 8 N. R. 12 E.
3 miles (distance) N.E. (direction) of Cumas (nearest town)

WELL PURPOSE: Home
 (home, irrigation, municipal, industrial)


- WELL COMPLETION DATA:
- (1) diameter (inches) 2"
 - (2) total depth (feet) 240 ft
 - (3) static water level (feet) 3' below above top of ground.
 - (4) casing PVC 230'
 (material) (depth)
 (size) if telescope see back.
 - (5) screen 10', 230'
 (length) (depth to top)
2", PVC
 (size) (material)
 - (6) pump _____ (HP) _____ (yield gpm)
 (type power)
 - (7) electric log _____ (yes or no)
 (organization running log)
 - (8) how well bottom plugged Seal

DRILLERS REMARKS: Owner had his own pump

DEPT. OF NATURAL RESOURCES
 BUREAU OF LAND & WATER RESOURCES
 RECEIVED
 OCT 19 1981

If well telescopes please sketch and show depths.

GROUND LEVEL

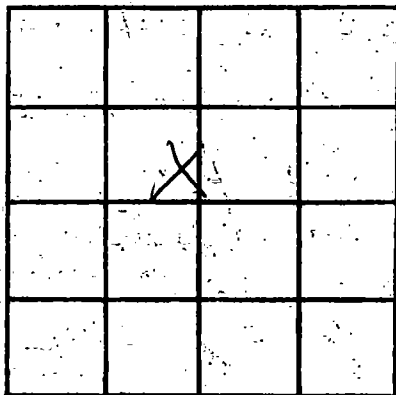

SECTION 12

Please indicate well location X.

ADDITIONAL INFORMATION

If more than one screen, show locations of each on sketch.