

**MISSISSIPPI DEPARTMENT OF NATURAL RESOURCES**  
**Bureau of Land and Water Resources**  
 Southport Mall  
 P.O. Box 10631  
 Jackson, Mississippi 39209  
**WATER WELL DRILLERS LOG**

Harrison  
0  
2077

Nov. 16 1981 Duncan Well Drilling Harrison  
 date well completed firm name county well located

LANDOWNER: Mr. Rheinhardt  
Pineville Road  
Pass Christian, Ms.  
 (mailing address)

description of formations encountered	from	to
<u>top Sand</u>	<u>0</u>	<u>30</u>
<u>Blue Clay</u>	<u>30</u>	<u>90</u>
<u>Sand + Blue &amp; white clay</u>	<u>90</u>	<u>150</u>
<u>Blue Clay</u>	<u>150</u>	<u>170</u>
<u>coarse Sand</u>	<u>170</u>	<u>200</u>

WELL LOCATION:  
 sec. 8 T. 8 N. R. 12 E.  
6 miles NE of Pass Christian  
 (distance) (direction) (nearest town)

WELL PURPOSE: Home  
 (home, irrigation, municipal, industrial)

- WELL COMPLETION DATA:
- (1) diameter (inches) 2"
  - (2) total depth (feet) 200ft.
  - (3) static water level (feet) 20' <sup>below</sup> ~~above~~ top of ground.
  - (4) casing PVC 90'  
 (material) (depth)
  - (size) If telescope see back.
  - (5) screen 10' 190'  
 (length) (depth to top)
  - (size) 2" (material) PVC
  - (6) pump 1 12  
 (HP) (yield gpm)
  - (type power) electric
  - (7) electric log             
 (yes or no)

(organization running log)           

(8) how well bottom plugged Sand  
Shark

DRILLERS REMARKS:           


DEPT. OF NATURAL RESOURCES  
 BUREAU OF LAND & WATER RESOURCES

FEB 11 1982

**RECEIVED**

If well telescopes please sketch and show depths.

GROUND LEVEL

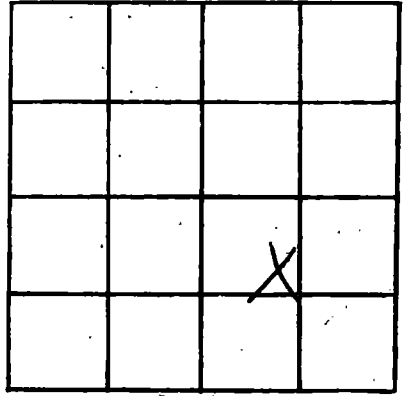

SECTION 8

Please indicate well location X.

ADDITIONAL INFORMATION

If more than one screen, show locations of each on sketch.