

**MISSISSIPPI DEPARTMENT OF NATURAL RESOURCES**  
**Bureau of Land and Water Resources**  
 Southport Mall  
 P.O. Box 10631  
 Jackson, Mississippi 39209  
**WATER WELL DRILLERS LOG**

Harrison  
0  
2078

Jan. 5 1982 Duncan Well Drilling Harrison Harrison  
 date well completed firm name county well located

**LANDOWNER:** Sophia Borodenka  
Moaraw Drive  
Pass Christian, Ms  
 (mailing address)

description of formations encountered	depth	
	from	to
<u>clay &amp; sand mixed</u>	<u>0</u>	<u>100</u>
<u>white clay</u>	<u>100</u>	<u>210</u>
<u>fine sand</u>	<u>210</u>	<u>240</u>
<u>coarse sand</u>	<u>240</u>	<u>258</u>

**WELL LOCATION:**  
 sec. 12 T. 8 N R. 12 E  
3 miles N of Crown  
 (distance) (direction) (nearest town)

**WELL PURPOSE:** Home  
 (home, irrigation, municipal, industrial)

- WELL COMPLETION DATA:**
- (1) diameter (inches) 2"
  - (2) total depth (feet) 258'
  - (3) static water level (feet) 5' below above top of ground.
  - (4) casing PVC, 248'  
 (material) (depth)
  - (size) If telescope see back.
  - (5) screen 10', 248'  
 (length) (depth to top)
  - 2", PVC  
 (size) (material)
  - (6) pump 1 (HP)  (yield gpm)
  - (type power)
  - (7) electric log  (yes or no)
  - (organization running log)
  - (8) how well bottom plugged Sand  
Mark

**DRILLERS REMARKS:** Owners  
had their own  
pump


DEPT. OF NATURAL RESOURCES  
 BUREAU OF LAND & WATER RESOURCES

FEB 11 1982

**RECEIVED**

If well telescopes please sketch and show depths.

GROUND LEVEL

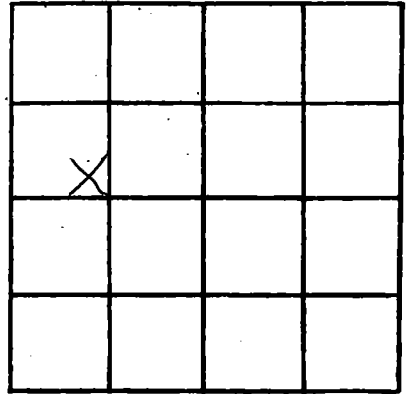

SECTION 12

Please indicate well location X.

ADDITIONAL INFORMATION

If more than one screen, show locations of each on sketch.