

MISSISSIPPI DEPARTMENT OF NATURAL RESOURCES

Bureau of Land and Water Resources

Southport Mall

P.O. Box 10631

Jackson, Mississippi 39209

WATER WELL DRILLERS LOG

Harrison
0
2079

Jan. 9 1982 Duncan Well Drilling Harrison
 date well completed firm name county well located

LANDOWNER: <u>Victor Vincino</u>	description of formations encountered	from	to
<u>2413 Victor St.</u> <u>Chalmette, La.</u> (mailing address)			
WELL LOCATION: sec. <u>12</u> T <u>8</u> N R <u>12</u> E <u>3</u> miles <u>N</u> of <u>Cuevas</u> (distance) (direction) (nearest town)	<u>Sand + Mud</u>	<u>0</u>	<u>20</u>
WELL PURPOSE: <u>Home</u> (home, irrigation, municipal, industrial)	<u>Blue clay</u>	<u>20</u>	<u>160</u>
WELL COMPLETION DATA: (1) diameter (inches) <u>2"</u>	<u>Blue clay</u>	<u>160</u>	<u>240</u>
(2) total depth (feet) <u>315</u>	<u>fine sand</u>	<u>240</u>	<u>280</u>
(3) static water level (feet) <u>10'</u> <u>below</u> above top of ground.	<u>coarse sand</u>	<u>280</u>	<u>315</u>
(4) casing <u>PVC</u> , <u>305</u> (material) (depth)			
(size) If telescope see back.			
(5) screen <u>10'</u> , <u>305</u> (length) (depth to top)			
<u>2"</u> , <u>PVC</u> (size) (material)			
(6) pump _____ (HP) _____ (yield gpm)			
(type power) _____			
(7) electric log _____ (yes or no)			
(organization running log) _____			
(8) how well bottom plugged <u>Sand</u> <u>shard</u>			
DRILLERS REMARKS: <u>Owner had his own pump</u>			


DEPT. OF NATURAL RESOURCES
BUREAU OF LAND & WATER RESOURCES

FEB 11 1982

RECEIVED

If well telescopes please sketch and show depths.

GROUND LEVEL

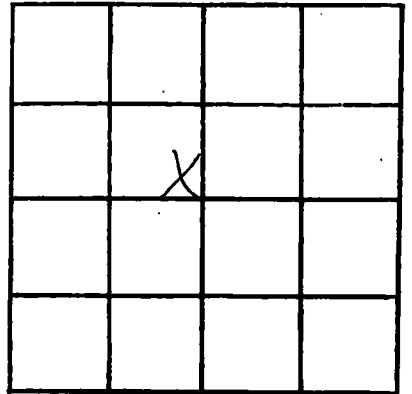

SECTION 12

Please indicate well location X.

ADDITIONAL INFORMATION

If more than one screen, show locations of each on sketch.