

MISSISSIPPI DEPARTMENT OF NATURAL RESOURCES
Bureau of Land and Water Resources
 Southport Mall
 P.O. Box 10631
 Jackson, Mississippi 39209
WATER WELL DRILLERS LOG

Harrison
0
2081

Jan. 15 1982 Duncan Well Drilling Harrison
 date well completed firm name county well located

LANDOWNER: Samuel McCauley
Rt. 1 Box 47
Long Beach Mo. 39560
 (mailing address)

description of formations encountered	from	to
	<u>Sand & Mud</u>	<u>0</u>
<u>Blue Clay</u>	<u>25</u>	<u>170</u>
<u>Blue & Red Clay</u>	<u>170</u>	<u>190</u>
<u>fine sand</u>	<u>190</u>	<u>210</u>
<u>Coarse Sand</u>	<u>210</u>	<u>230</u>

WELL LOCATION:
 sec. 12 T. 8 N. R. 12 E.
3 miles N. of Cuervas
 (distance) (direction) (nearest town)

WELL PURPOSE: Home
 (home, irrigation, municipal, industrial)

WELL COMPLETION DATA:

(1) diameter (inches) 2"

(2) total depth (feet) 230 ft.

(3) static water level (feet) 5' below above top of ground.

(4) casing PVC, 220'
 (material) (depth)

10' if telescope see back.
 (size)

(5) screen 10', 220'
 (length) (depth to top)

2", PVC
 (size) (material)

(6) pump _____ (HP) _____ (yield gpm)

_____ (type power)

(7) electric log _____ (yes or no)

_____ (organization running log)

(8) how well bottom plugged Sand
Shark

DRILLERS REMARKS:
Owner had his own pump


DEPT. OF NATURAL RESOURCES
 BUREAU OF LAND & WATER RESOURCES

FEB 11 1982

RECEIVED

If well telescopes please sketch and show depths.

GROUND LEVEL

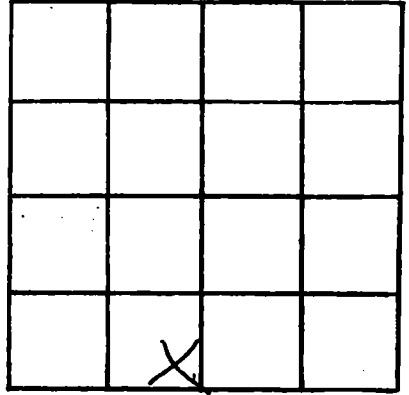

SECTION 12

Please indicate well location X.

ADDITIONAL INFORMATION

A series of horizontal lines for writing additional information.

If more than one screen, show locations of each on sketch.