

MISSISSIPPI DEPARTMENT OF NATURAL RESOURCES

Bureau of Land and Water Resources

Southport Mall

P.O. Box 10631

Jackson, Mississippi 39209

WATER WELL DRILLERS LOG

Harrison
2082

date well completed Mar. 20, 1982 firm name Duncan Well Drilling county well located Harrison

LANDOWNER: B.E. Martin  
Rt. 2 Box 7  
Pass Christian, Ms.  
 (mailing address)

description of formations encountered	depth	
	from	to
Sand & mud	0	15
Blue clay	15	160
fine sand	160	180
Coarse sand	180	195

WELL LOCATION:  
 sec. 12 T. 8 N. R. 12 E.  
3 miles N. of Cuevas  
 (distance) (direction) (nearest town)

WELL PURPOSE:  
 (home, irrigation, municipal, industrial)

WELL COMPLETION DATA:

- (1) diameter (inches) 2"
- (2) total depth (feet) 195 ft.
- (3) static water level (feet) 10'  below  above top of ground.
- (4) casing PVC, 185'  
 (material) (depth)  
 (size) if telescope see back.
- (5) screen 10', 185'  
 (length) (depth to top)  
2", PVC  
 (size) (material)
- (6) pump \_\_\_\_\_ (HP) \_\_\_\_\_ (yield gpm)  
 (type power)
- (7) electric log (yes or no) \_\_\_\_\_  
 (organization running log)
- (8) how well bottom plugged Sand  
Shark

DRILLERS REMARKS:  
Owner had his own pump


DEPT. OF NATURAL RESOURCES  
 BUREAU OF LAND & WATER RESOURCES

FEB 11 1982

RECEIVED

If well telescopes please sketch and show depths.

GROUND LEVEL

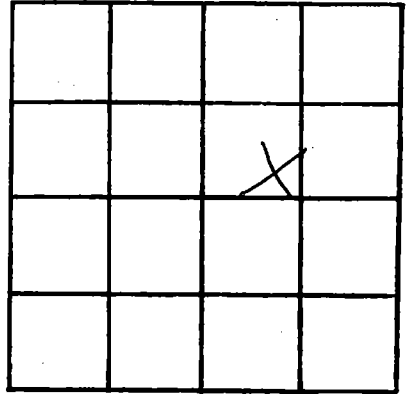

SECTION 12

Please indicate well location X.

ADDITIONAL INFORMATION

If more than one screen,  
show locations of each on sketch.