

MISSISSIPPI DEPARTMENT OF NATURAL RESOURCES

Bureau of Land and Water Resources

Southport Mall

P.O. Box 10631

Jackson, Mississippi 39209

WATER WELL DRILLERS LOG

Harrison
0
2084

Jan. 26 1982 Duncan Well Drilling Harrison  
 date well completed firm name county well located

LANDOWNER: Patsy Colan  
Bayou Dr.  
Pass Christian  
 (mailing address)

description of formations encountered	depth	
	from	to
<u>Sand &amp; Mud</u>	<u>0</u>	<u>20</u>
<u>Blue Clay</u>	<u>20</u>	<u>140</u>
<u>Fine Sand</u>	<u>140</u>	<u>160</u>
<u>Coarse Sand</u>	<u>160</u>	<u>180</u>

WELL LOCATION:  
 sec. 12 T. 8 N. R. 12 E.  
3 miles N of Quevas  
 (distance) (direction) (nearest town)

WELL PURPOSE: Home  
 (home, irrigation, municipal, industrial)

WELL COMPLETION DATA:  
 (1) diameter (inches) 2"  
 (2) total depth (feet) 180 ft  
 (3) static water level (feet) 20' below above top of ground.  
 (4) casing PVC, 170'  
 (material) (depth)  
 (size) If telescope see back.  
 (5) screen 10', 170'  
 (length) (depth to top)  
2", PVC  
 (size) (material)  
 (6) pump \_\_\_\_\_ (HP) \_\_\_\_\_ (yield gpm)  
 (type power) \_\_\_\_\_  
 (7) electric log \_\_\_\_\_ (yes or no)  
 (organization running log) \_\_\_\_\_

(8) how well bottom plugged Sand  
Blank

DRILLERS REMARKS: Owner  
had his own  
pump


DEPT. OF NATURAL RESOURCES  
 BUREAU OF LAND & WATER RESOURCES

FEB 11 1982

RECEIVED

If well telescopes please sketch and show depths.

GROUND LEVEL

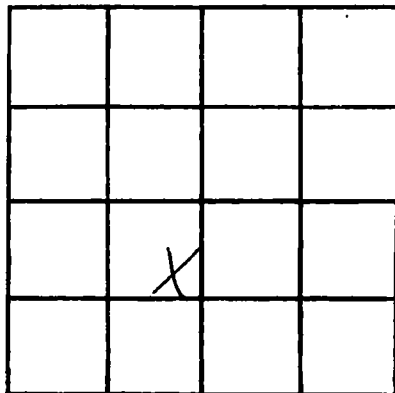

SECTION 12

Please indicate well location X.

ADDITIONAL INFORMATION

If more than one screen, show locations of each on sketch.