

MISSISSIPPI DEPARTMENT OF NATURAL RESOURCES

Bureau of Land and Water Resources

Southport Mall

P.O. Box 10631

Jackson, Mississippi 39209

WATER WELL DRILLERS LOG

Harrison
0
2085

6/3 1982 Reyman Well Co. Harrison County
 date well completed firm name county well located

LANDOWNER: Herb Stolley
Rt. 1, Box 77
Long Beach, 39560
 (mailing address)

description of formations encountered	from	to
<u>Sand Clay</u>	<u>0</u>	<u>110</u>
<u>Gravel</u>		
<u>Blue clay</u>	<u>110</u>	<u>240</u>
<u>fine sand</u>	<u>240</u>	<u>310</u>
<u>Blue Clay</u>	<u>310</u>	<u>440</u>
<u>fine sand</u>	<u>440</u>	<u>490</u>
<u>Medium to good sand</u>	<u>490</u>	<u>550</u>
<u>Sand</u>		

WELL LOCATION:
 sec 16 T 8 N R 12 E
3 miles S of Long Beach
 (distance) (direction) (nearest town)

WELL PURPOSE: None
 (home, irrigation, municipal, industrial)

WELL COMPLETION DATA:
 (1) diameter (inches) 2"
 (2) total depth (feet) 550
 (3) static water level (feet) 8' below top of ground.
 (4) casing PVC, 535'
 (material) (depth)
2"
 (size) If telescope see back.
 (5) screen 15', 550
 (length) (depth to top)
2", PVC
 (size) (material)
 (6) pump 1 1/2 K
 (HP) (yield gpm)
Elect
 (type power)
 (7) electric log no
 (yes or no)
no
 (organization running log) Sand Shark
 (8) how well bottom plugged Sand Shark

DRILLERS REMARKS:


DEPT. OF NATURAL RESOURCES
 BUREAU OF LAND & WATER RESOURCES

JUL 20 1982

RECEIVED

If well telescopes please sketch and show depths.

GROUND LEVEL

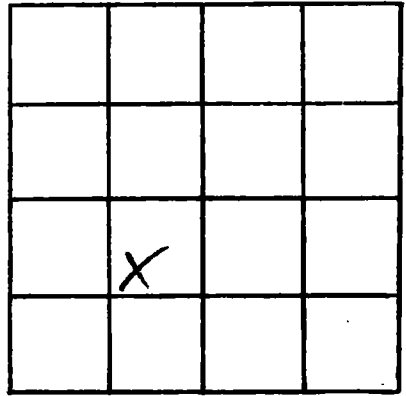

SECTION 16

Please indicate well location X.

ADDITIONAL INFORMATION

If more than one screen, show locations of each on sketch.