

MISSISSIPPI DEPARTMENT OF NATURAL RESOURCES

Bureau of Land and Water Resources

Southport Mall

P.O. Box 10631

Jackson, Mississippi 39209

WATER WELL DRILLERS LOG

Harrison
0
2086

March 15 1982 Duncan Well Drilling Harrison
 date well completed firm name county well located

LANDOWNER: Thermy Davisport
Pl. 1 Box 1325
Shulpsit, Mo. 39501
 (mailing address)

description of formations encountered	from	to
<u>Sand</u>	<u>0</u>	<u>20</u>
<u>Clay</u>	<u>20</u>	<u>40</u>
<u>fine sand</u>	<u>40</u>	<u>60</u>
<u>Blue clay</u>	<u>60</u>	<u>85</u>
<u>coarse sand</u>	<u>85</u>	<u>105</u>

WELL LOCATION:
 sec: 4 T. 8 N R. 12 E
3 miles DW of Shulpsit
 (distance) (direction) (nearest town)

WELL PURPOSE: Home
 (home, irrigation, municipal, industrial)

WELL COMPLETION DATA:
 (1) diameter (inches) 2"
 (2) total depth (feet) 105'
 (3) static water level (feet) 8' below above top of ground.
 (4) casing PVC, 95'
 (material) (depth)
 (size) If telescope see back.
 (5) screen 10', 95'
 (length) (depth to top)
2", PVC
 (size) (material)
 (6) pump _____ (HP) _____ (yield gpm)
electric
 (type power)
 (7) electric log _____ (yes or no)
 _____ (organization running log)
 (8) how well bottom plugged Sand
Shark

DRILLERS REMARKS: Owner installed his own pump.


DEPT. OF NATURAL RESOURCES
 BUREAU OF LAND & WATER RESOURCES

AUG 30 1982

RECEIVED

If well telescopes please sketch and show depths.

GROUND LEVEL

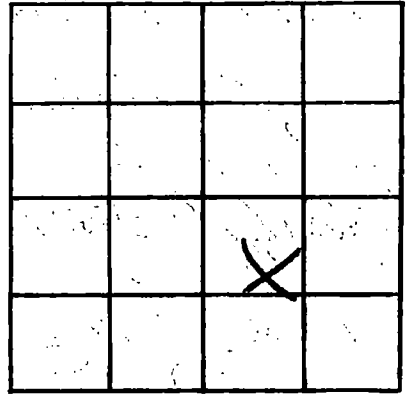

SECTION 34

Please indicate well location X.

ADDITIONAL INFORMATION

If more than one screen, show locations of each on sketch.