

MISSISSIPPI DEPARTMENT OF NATURAL RESOURCES

Bureau of Land and Water Resources

Southport Mall

P.O. Box 10631

Jackson, Mississippi 39209

WATER WELL DRILLERS LOG

Darius
0
2088

Oct 13 1982
date well completed

Broder Pump & Well Service
firm name

county well located

LANDOWNER: *John Wilkerson*
RA. Box 55
Long Beach, Miss.
(mailing address)

WELL LOCATION:
sec. *8* T. *8* S. R. *12* W.
2 miles *NE* of *Pass Christian*
(distance) (direction) (nearest town)

WELL PURPOSE: *Home*
(home, irrigation, municipal, industrial)

- WELL COMPLETION DATA:
- (1) diameter (inches) *4" x 2"*
 - (2) total depth (feet) *480*
 - (3) static water level (feet) *22* below top of ground.
 - (4) casing *PVC*, *480*
(material), (depth)
4" x 2"
(size) if telescope see back.
 - (5) screen *10*, *430*
(length), (depth to top)
2", *PVC*
(size), (material)
 - (6) pump *1*, *20*
(HP), (yield gpm)
220V 1Ø
(type power)
 - (7) electric log *No*
(yes or no)

(organization running log)

(8) how well bottom plugged
2" PVC sand shock

DRILLERS REMARKS:

description of formations encountered	from	to
<i>Surface</i>	<i>0</i>	<i>10</i>
<i>Sand</i>	<i>10</i>	<i>40</i>
<i>Sand & Clay layers</i>	<i>40</i>	<i>80</i>
<i>Blue Clay</i>	<i>80</i>	<i>120</i>
<i>Sand & Clay layers</i>	<i>120</i>	<i>300</i>
<i>Blue Clay</i>	<i>300</i>	<i>415</i>
<i>Sand</i>	<i>415</i>	<i>445</i>
<i>Clay & Sand layers</i>	<i>445</i>	<i>480</i>

DEPT. OF NATURAL RESOURCES
BUREAU OF LAND & WATER RESOURCES

NOV 15 1982

RECEIVED

If well telescopes please sketch and show depths.

GROUND LEVEL

4" PVC

200 FT

2" PVC

430 →


2" x 10 FT
SCREEN

440 →

2" PVC

480

2" Sand Shank

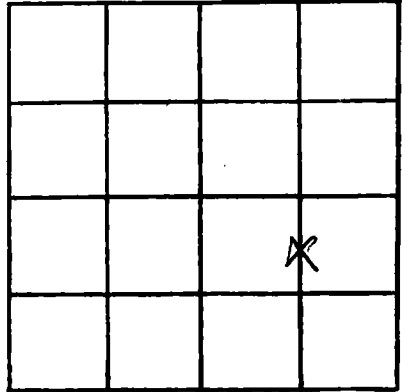

SECTION 8

Please indicate well location X.

ADDITIONAL INFORMATION

If more than one screen,
show locations of each on sketch.