

MISSISSIPPI DEPARTMENT OF NATURAL RESOURCES

Bureau of Land and Water Resources

Southport Mall

P.O. Box 10631

Jackson, Mississippi 39209

COASTAL DRILLING & SERVICE CO. WATER WELL DRILLERS LOG

Hansen
 0
 2090

8/25/82

ROUTE 1 BOX 518

Hansen

date well completed

firm name

county well located

BILOXI MISS. 39532

LANDOWNER

Oliver Beach

description of formations encountered

from

to

Long Beach, MS

<i>top soil</i>	<i>1</i>	<i>3</i>
<i>Red Clay</i>	<i>3</i>	<i>15</i>
<i>White pipe clay</i>	<i>15</i>	<i>30</i>
<i>white sand</i>	<i>30</i>	<i>60</i>
<i>Soft Blue Clay</i>	<i>60</i>	<i>180</i>
<i>fine water sand</i>	<i>180</i>	<i>215</i>
<i>fine water sand</i>	<i>215</i>	<i>230</i>

(mailing address)

WELL LOCATION:

sec *3* T *8* N R *12* E
 S W

Amal #3
 (distance) miles (direction) of (nearest town)

WELL PURPOSE:

(home, irrigation, municipal, industrial) *home*

WELL COMPLETION DATA:

- (1) diameter (inches) *2"*
- (2) total depth (feet) *230'*
- (3) static water level (feet) *20'* below above top of ground
- (4) casing *PC* *220'*
 (material) (depth)
- (size) If telescope see back.
- (5) screen *10'* *220'*
 (length) (depth to top)
- 2"*
 (size) (material)
- (6) pump *15*
 (HP) (yield gpm)
- 5hp*
 (type power)
- (7) electric log *SW*
 (yes or no)

(organization running log)

(8) how well bottom plugged

2' back with valve


DRILLERS REMARKS: *19-13*

DEPT. OF NATURAL RESOURCES
 BUREAU OF LAND & WATER RESOURCES

DEC 1 1982
 RECEIVED

If well telescopes please sketch and show depths.

GROUND LEVEL

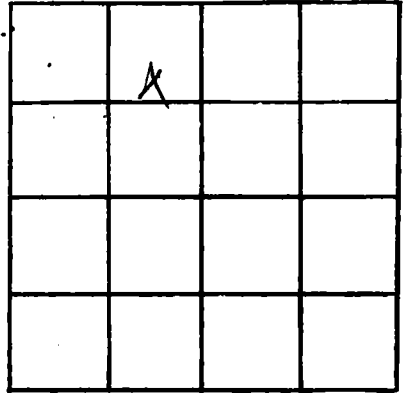

SECTION _____

Please indicate well location X.

ADDITIONAL INFORMATION

If more than one screen, show locations of each on sketch.