

**MISSISSIPPI DEPARTMENT OF NATURAL RESOURCES**  
**Bureau of Land and Water Resources**  
 Southport Mall  
 P.O. Box 10631  
 Jackson, Mississippi 39209  
**WATER WELL DRILLERS LOG**

Harrison  
D  
2092

9-28 1982 Borden Pump Well Ser. Harrison  
 date well completed firm name county well located

**LANDOWNER:**  
John G Koshak  
Paula Arive - Long Beach, Miss.  
 (mailing address)

**WELL LOCATION:**  
 sec. 12 T. 8 N. R. 12 E.  
1 miles N of Long Beach  
 (distance) (direction) (nearest town)

**WELL PURPOSE:** Home  
 (home, irrigation, municipal, industrial)

- WELL COMPLETION DATA:**
- (1) diameter (inches) 4" X 2"
  - (2) total depth (feet) 560 FT
  - (3) static water level (feet) \_\_\_\_\_ below  
 top of ground. above
  - (4) casing PVC 800,  
 (material) (depth)  
4" X 2"  
 (size) If telescope see back.
  - (5) screen 10 FT 830  
 (length) (depth to top)  
2" PVC  
 (size) (material)
  - (6) pump 1 HP 20  
 (HP) (yield gpm)  
220 V 1Ø  
 (type power)
  - (7) electric log No  
 (yes or no)  
 \_\_\_\_\_  
 (organization running log)
  - (8) how well bottom plugged  
2 1/2 Sand Shock

description of formations encountered	from	to
Surface	0	30
Sand & Clay	30	50
Sand	50	80
Clay - Blue	100	150
Sand	150	200
Blue Clay	200	260
Sand	260	320
Blue Clay	320	470
Sand	470	520
Blue Clay	520	750
Grey Sand	750	860
		+

DEPT. OF NATURAL RESOURCES  
 BUREAU OF LAND & WATER RESOURCES

OCT 25 1982  
**RECEIVED**

**DRILLERS REMARKS:**

If well telescopes please sketch and show depths.

GROUND LEVEL

400  
PVC

200

2"  
PVC


830 →

840 →

2" PVC →

860

← 2" Sand  
Shank

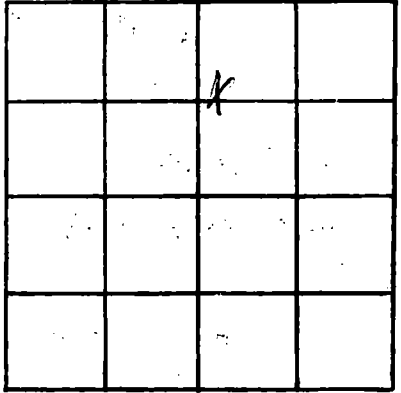

SECTION 12

Please indicate well location X.

ADDITIONAL INFORMATION

If more than one screen, show locations of each on sketch.