

MISSISSIPPI DEPARTMENT OF NATURAL RESOURCES

Bureau of Land and Water Resources

Southport Mall

P.O. Box 10631

Jackson, Mississippi 39209

WATER WELL DRILLERS LOG

Harrison  
0  
2093

Nov. 22 1982 Harrison Well Drilling Harrison  
 date well completed firm name county well located

LANDOWNER: James Dollar, Co.  
1160 E. Old Pass Road.  
Long Beach, Ms. 39560  
 (mailing address)

description of formations encountered	from to	
<u>Sand</u>	<u>0</u>	<u>90</u>
<u>mixed Sand &amp; Clay</u>	<u>90</u>	<u>210</u>
<u>Blue Clay</u>	<u>210</u>	<u>330</u>
<u>mixed Clay &amp; Sand</u>	<u>330</u>	<u>390</u>
<u>fine Sand</u>	<u>390</u>	<u>430</u>
<u>Course Sand</u>	<u>430</u>	<u>462</u>

WELL LOCATION:  
 sec. 10 T. 8 N. R. 14 E.  
3 miles N of Long Beach  
 (distance) (direction) (nearest town)

WELL PURPOSE: Home  
 (home, irrigation, municipal, industrial)

WELL COMPLETION DATA:  
 (1) diameter (Inches) 4 1/2" 362-2"  
 (2) total depth (feet) 462 ft.  
 (3) static water level (feet) 20' below above top of ground.  
 (4) casing PVC 452,  
 (material) (depth)  
102 If telescope see back.  
 (size)  
 (5) screen 10', 452  
 (length) (depth to top)  
2, PVC  
 (size) (material)  
 (6) pump 1 (HP) 20 (yield gpm)  
electric  
 (type power)  
 (7) electric log                       
 (yes or no)  
    
 (organization running log)  
 (8) how well bottom plugged Sand  
Shark

DRILLERS REMARKS:   


DEPT. OF NATURAL RESOURCES  
 BUREAU OF LAND & WATER RESOURCES

JAN 21 1983

RECEIVED

If well telescopes please sketch and show depths.

GROUND LEVEL

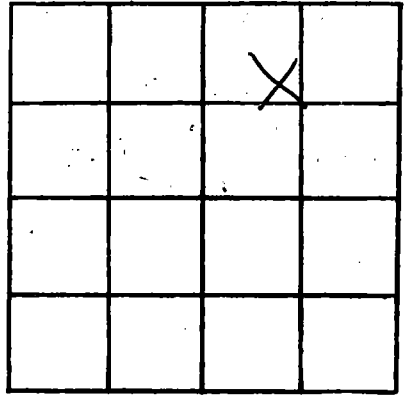

SECTION 10

Please indicate well location X.

ADDITIONAL INFORMATION

If more than one screen, show locations of each on sketch.