

MISSISSIPPI DEPARTMENT OF NATURAL RESOURCES

Bureau of Land and Water Resources

Southport Mall

P.O. Box 10631

Jackson, Mississippi 39209

WATER WELL DRILLERS LOG

Harrison
0
2094

Oct. 6 1982 Harrison Well Drilling Harrison
 date well completed firm name county well located

LANDOWNER: James Jones
Rt. 1 Box 315
Pass Christian, Ms. 39571
 (mailing address)

description of formations encountered	from	to
<u>Top Sand</u>	<u>0</u>	<u>18</u>
<u>mixed sand, white & blue clay</u>	<u>18</u>	<u>110</u>
<u>Blue Clay</u>	<u>110</u>	<u>150</u>
<u>Clay & Sand</u>	<u>150</u>	<u>200</u>
<u>Coarse Sand</u>	<u>200</u>	<u>210</u>

WELL LOCATION:
 sec. 5 T. 8 N. R. 12 E.
8 miles NE of Cuscuta
 (distance) (direction) (nearest town)

WELL PURPOSE: Home
 (home, irrigation, municipal, industrial)

WELL COMPLETION DATA:

(1) diameter (inches) 2"
 (2) total depth (feet) 210
 (3) static water level (feet) 25' below above top of ground.
 (4) casing PVC, 200
 (material) (depth)
 (size) if telescope see back.
 (5) screen 10', 200
 (length) (depth to top)
2", PVC
 (size) (material)
 (6) pump 1, 8
 (HP) (yield gpm)
electric
 (type power)
 (7) electric log
 (yes or no)

 (organization running log)
 (8) how well bottom plugged

DRILLERS REMARKS: installed
owners pump


DEPT. OF NATURAL RESOURCES
 BUREAU OF LAND & WATER RESOURCES

JAN 21 1983

RECEIVED

If well telescopes please sketch and show depths.

GROUND LEVEL

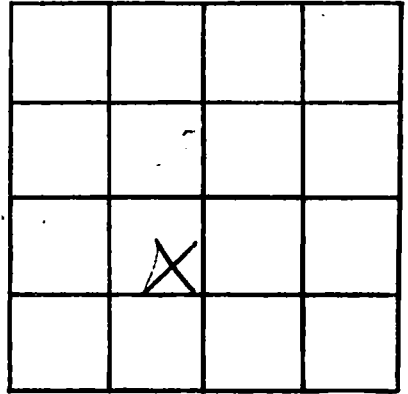

SECTION 5

Please indicate well location X.

ADDITIONAL INFORMATION

If more than one screen, show locations of each on sketch.