

**MISSISSIPPI DEPARTMENT OF NATURAL RESOURCES**  
**Bureau of Land and Water Resources**  
 Southport Mall  
 P.O. Box 10631  
 Jackson, Mississippi 39209  
**WATER WELL DRILLERS LOG**

Harrison  
0  
296

Feb. 1 1983 Braden Pump & Well Harrison  
 date well completed Service firm name Inc. county well located

**LANDOWNER:** Jess Griffin  
122 Shadowlawn  
Pass Christian, Ms. 39577  
 (mailing address)

description of formations encountered	from	to
surface	0	6
clay	6	20
white sand	20	60
blue slay	60	190
gray sand	190	220

**WELL LOCATION:**  
 sec. 21 T. S R. 12 E  
1 miles W of Long Beach  
 (distance) (direction) (nearest town)

**WELL PURPOSE:** lawn well  
 (home, irrigation, municipal, industrial)

- WELL COMPLETION DATA:**
- (1) diameter (inches) 2"
  - (2) total depth (feet) 220 ft.
  - (3) static water level (feet) 30 <sup>below</sup> ~~at~~ top of ground.
  - (4) casing PVC, 210  
 (material) (depth)  
Sch. 40  
 (size) if telescope see back.
  - (5) screen 10 ft. 210  
 (length) (depth to top)  
2" PVC!  
 (size) (material)
  - (6) pump 1 10  
 (HP) (yield gpm)  
220  
 (type power)
  - (7) electric log no  
 (yes or no)  
 (organization running log)
  - (8) how well bottom plugged PVC sand shark

DEPT. OF NATURAL RESOURCES  
 BUREAU OF LAND & WATER RESOURCES


FEB 24 1983

**RECEIVED**

**DRILLERS REMARKS:**

If well telescopes please sketch and show depths.

GROUND LEVEL

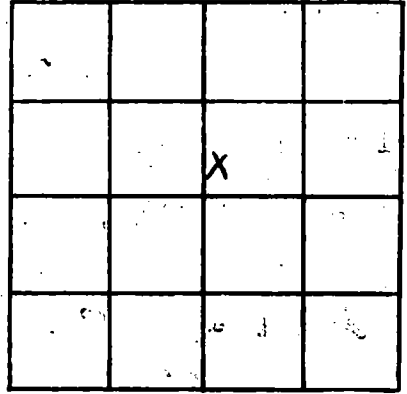

SECTION 21

Please indicate well location X.

ADDITIONAL INFORMATION

If more than one screen, show locations of each on sketch.