

MISSISSIPPI DEPARTMENT OF NATURAL RESOURCES

Bureau of Land and Water Resources

Southport Mall

P.O. Box 10631

Jackson, Mississippi 39209

WATER WELL DRILLERS LOG

Harrison
0
2097

1-6 1983 Duncan Well Drilling Harrison
 date well completed firm name county well located

LANDOWNER: Wallace Swain
P.O. Box 57
Long Beach, Ms. 3956
 (mailing address)

description of formations encountered	depth	
	from	to
<u>sandy soil</u>	<u>0</u>	<u>23</u>
<u>white + blue clay</u>	<u>23</u>	<u>110</u>
<u>course sand</u>	<u>110</u>	<u>126</u>

WELL LOCATION:
 sec. 5 T. 8 N. R. 12 E.
3 miles NW of Long Beach
 (distance) (direction) (nearest town)

WELL PURPOSE: Home
 (home, irrigation, municipal, industrial)

WELL COMPLETION DATA:
 (1) diameter (inches) 2"
 (2) total depth (feet) 126
 (3) static water level (feet) 12' below above top of ground.
 (4) casing PVC, 116,
 (material) (depth)
 (size) if telescope see back.
 (5) screen 10', 116
 (length) (depth to top)
2", PVC
 (size) (material)
 (6) pump 1, 8
 (HP) (yield gpm)
electric
 (type power)
 (7) electric log _____
 (yes or no)

 (organization running log)
 (8) how well bottom plugged Sand
Shark

DRILLERS REMARKS:


DEPT. OF NATURAL RESOURCES
 BUREAU OF LAND & WATER RESOURCES

AUG 12 1983

RECEIVED

If well telescopes please sketch and show depths.

GROUND LEVEL

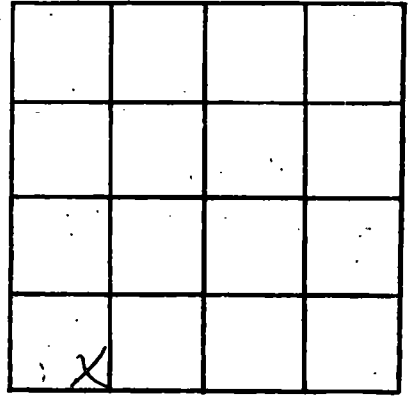

SECTION 5

Please indicate well location X.

ADDITIONAL INFORMATION

If more than one screen, show locations of each on sketch.