

MISSISSIPPI DEPARTMENT OF NATURAL RESOURCES

Bureau of Land and Water Resources

Southport Mall

P.O. Box 10631

Jackson, Mississippi 39209

WATER WELL DRILLERS LOG

Harrison
0
2099

2-19-1983 Mobile Wells, Inc. Harrison
 date well completed firm name county well located

LANDOWNER: Mike Mate
407 Mates Ave.
P.O. Ms. well on Merge Ave
 (mailing address)

description of formations encountered	from	to
MUD	0	240
SAND	240	260
SAND	260	280
SAND	280	300

WELL LOCATION:
 sec 5 T 8 N R 12 E
4 miles E of P.C.
 (distance) (direction) (nearest town)

WELL PURPOSE: Home
 (home irrigation, municipal, industrial)

- WELL COMPLETION DATA:
- (1) diameter (inches) 2"
 - (2) total depth (feet) 300
 - (3) static water level (feet) 25 ^{below} above top of ground.
 - (4) casing Sch 40 PVC 290
 (material) (depth)
2"
 (size) If telescope see back.
 - (5) screen 10' 2"
 (length) (depth to top) (size) Sch 80 PVC
 (material)
 - (6) pump 1 electric
 (HP) (yield gpm) (type power)
 - (7) electric log
 (yes or no)
 (organization running log)
 - (8) how well bottom plugged sand
seal

DRILLERS REMARKS:


DEPT. OF NATURAL RESOURCES
 BUREAU OF LAND & WATER RESOURCES

AUG 9 1983

RECEIVED

If well telescopes please sketch and show depths.

GROUND LEVEL

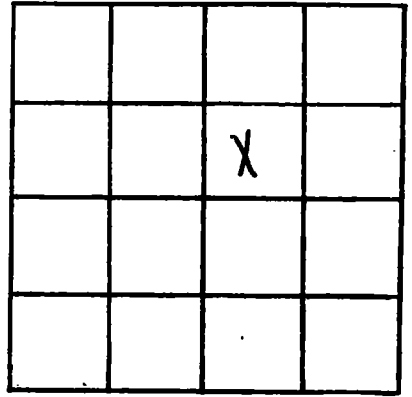

SECTION 5

Please indicate well location X.

ADDITIONAL INFORMATION

Lined area for additional information.

If more than one screen, show locations of each on sketch.