

MISSISSIPPI DEPARTMENT OF NATURAL RESOURCES

Bureau of Land and Water Resources

Southport Mall

P.O. Box 10631

Jackson, Mississippi 39209

WATER WELL DRILLERS LOG

Hanson
0
2100

March 29 1983 Duncan Well Drilling Harrison
 date well completed firm name county well located

LANDOWNER: Fury Crowe
Rt. 1 Box 365A
Long Beach Ms. 39560
 (mailing address)

description of formations encountered	depth	
	from	to
<u>Sandy Soil</u>	<u>0</u>	<u>10</u>
<u>Sand & Clay</u>	<u>10</u>	<u>80</u>
<u>Blue Clay</u>	<u>80</u>	<u>165</u>
<u>Forest Land</u>	<u>165</u>	<u>173</u>
<u>Course Sand</u>	<u>173</u>	<u>195</u>

WELL LOCATION:
 sec. 5 T. 8 N. R. 12 E.
3 miles NW of Long Beach
 (distance) (direction) (nearest town)

WELL PURPOSE: Some
 (home, irrigation, municipal, industrial)

- WELL COMPLETION DATA:
- (1) diameter (inches) 2"
 - (2) total depth (feet) 195 ft.
 - (3) static water level (feet) 12' below above top of ground.
 - (4) casing PVC, 185,
 (material) (depth)
 (size) if telescope see back.
 - (5) screen 10', 185'
 (length) (depth to top)
2", PVC
 (size) (material)
 - (6) pump 1, 9
 (HP) (yield gpm)
electric
 (type power)
 - (7) electric log
 (yes or no)

 (organization running log)
 - (8) how well bottom plugged sand
Shank

DRILLERS REMARKS: Owner
had his own
pump


DEPT. OF NATURAL RESOURCES
 BUREAU OF LAND & WATER RESOURCES

AUG 12 1983

RECEIVED

If well telescopes please sketch and show depths.

GROUND LEVEL

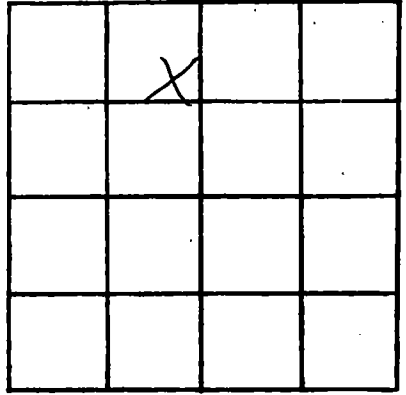

SECTION 5

Please indicate well location X.

ADDITIONAL INFORMATION

If more than one screen, show locations of each on sketch.