

MISSISSIPPI DEPARTMENT OF NATURAL RESOURCES

Bureau of Land and Water Resources

Southport Mall

P.O. Box 10631

Jackson, Mississippi 39209

WATER WELL DRILLERS LOG

Harrison
0
2101

4/13/83, Braden Pump Well Harrison
 date well completed firm name county well located

LANDOWNER: Scott Ebrite
 102 Hursey Ave.
 Pass Christian, Ms. 39571
 (mailing address)

description of formations encountered	from	to
sand	0	35
clay	35	50
sand	50	55
clay	55	90
sand	90	95
clay	95	100
sand	100	115
clay	115	140
sand	140	180

WELL LOCATION:
 sec. 21 T. 4 S. R. 12 E.
 1 miles W Long Beach
 (distance) (direction) of (nearest town)

WELL PURPOSE: Heat Pump
 (home, irrigation, municipal, industrial)

WELL COMPLETION DATA:
 (1) diameter (inches) 4"
 (2) total depth (feet) 180
 (3) static water level (feet) 30 below
 top of ground above
 (4) casing PVC, 170 ft
 (material) (depth)
 4" x 27" (size) if telescope see back.
 (5) screen 10, 170
 (length) (depth to top)
 2" PVC Underbon (size) (material)
 (6) pump 1/2 Subm, 20
 (HP) (yield gpm)
 220V 1/2 (type power)
 (7) electric log No
 (yes or no)
 (organization running log)
 (8) how well bottom plugged
 24 Sand Screen PVC

DRILLERS REMARKS: no
 tailpipe

DEPT. OF NATURAL RESOURCES
 BUREAU OF LAND & WATER RESOURCES

APR 20 1983

RECEIVED

If well telescopes please sketch and show depths.


GROUND LEVEL

4"
sch 40
pvc
Pipe

160
10ft 2" pvc

1ft

4x2 Budby?
10ft x 2"
pvc Screen

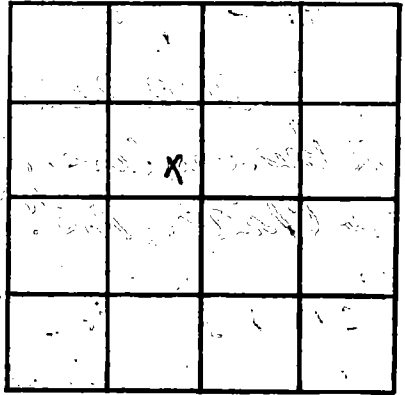

SECTION 21

Please indicate well location X.

ADDITIONAL INFORMATION

If more than one screen, show locations of each on sketch.