

MISSISSIPPI DEPARTMENT OF NATURAL RESOURCES

Bureau of Land and Water Resources

Southport Mall

P.O. Box 10631

Jackson, Mississippi 39209

WATER WELL DRILLERS LOG

Harrison
0
2006

6/29/83  
date well completed

Braden Pump & Well Serv.  
firm name

Harrison  
county well located

LANDOWNER: Theodore Lawyer  
315 McDonald Dr  
Pass Christian, Ms. 39571  
(mailing address)

description of formations encountered	from	to
sand	0	40
sand + gravel	40	60
sand	60	80
clay	80	220
sand & clay	220	230
clay	230	340
sand	340	345
sand + clay	345	360
clay	360	480
sand + clay	480	500
clay sand	500	570
clay	570	580

WELL LOCATION:  
30 sec. 8 T 8 N R. 12 S W  
In miles Pass Christian  
(distance) (direction) (nearest town)

WELL PURPOSE: Lawn Sprinkler  
(home, irrigation, municipal, industrial)

WELL COMPLETION DATA:  
 (1) diameter (inches) 4 X 2  
 (2) total depth (feet) 580 ft  
 (3) static water level (feet) 1 below top of ground.  
 (4) casing PVC 560 (material) (depth)  
 4 X 2 (size) If telescope see back.  
 (5) screen 10 560 (length) (depth to top)  
 2" PVC underbar (size) (material)  
 (6) pump 1 Subm 20 (HP) (yield gpm)  
 200 V 1 φ (type power)  
 (7) electric log No (yes or no)  
 (organization running log)  
 (8) how well bottom plugged PVC sand/shark

DRILLERS REMARKS: 10 ft tailpipe



DEPT. OF NATURAL RESOURCES  
BUREAU OF LAND & WATER RESOURCES

JUL 15 1983

RECEIVED

If well telescopes please sketch and show depths.

GROUND LEVEL

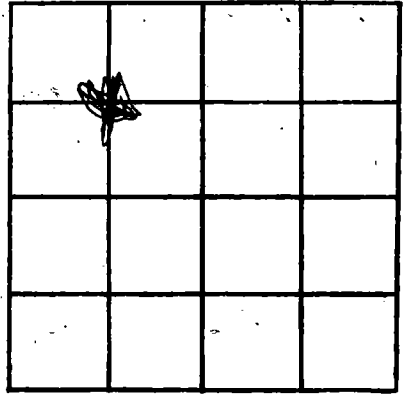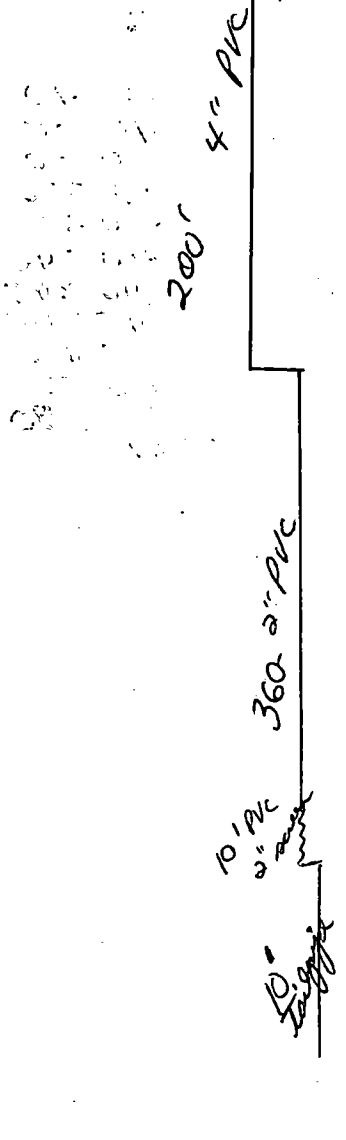

SECTION ~~26~~ 30

Please indicate well location X.

ADDITIONAL INFORMATION

A series of horizontal lines for recording additional information, starting below the "ADDITIONAL INFORMATION" header and extending to the bottom of the page.

If more than one screen, show locations of each on sketch.