

MISSISSIPPI DEPARTMENT OF NATURAL RESOURCES
Bureau of Land and Water Resources
 Southport Mall
 P.O. Box 10631
 Jackson, Mississippi 39209
WATER WELL DRILLERS LOG

<i>Harrison</i>
<i>0</i>
<i>2107</i>

7-18-83 *McKil Wells Inc.* *Harrison*
 date well completed firm name county well located

LANDOWNER: *Bob Vaughn*
211 Summit
Pass Christian, Ms
 (mailing address)

description of formations encountered	from	to
<i>sand</i>	<i>0</i>	<i>30</i>

WELL LOCATION:
 sec. *19* T *8* N R *12* E
6 miles *E* of *LIB*
 (distance) (direction) (nearest town)

WELL PURPOSE: *HOME*
 (home, irrigation, municipal, industrial)

WELL COMPLETION DATA:

- (1) diameter (inches) *2"*
- (2) total depth (feet) *30'*
- (3) static water level (feet) *6'* below above top of ground.
- (4) casing *40 PUC*, *90'*
 (material) (depth)
 (size) if telescope see back.
- (5) screen *10'*, *20'*
 (length) (depth to top)
2", *40 PUC*, *6 SLOT*
 (size) (material)
- (6) pump *1/2*, *10*
 (HP) (yield gpm)
electric
 (type power)
- (7) electric log *NO*
 (yes or no)
 (organization running log)

(8) how well bottom plugged *Sand Seal*

DRILLERS REMARKS:


DEPT. OF NATURAL RESOURCES
 BUREAU OF LAND & WATER RESOURCES

AUG 9 1983

RECEIVED

If well telescopes please sketch and show depths.

GROUND LEVEL

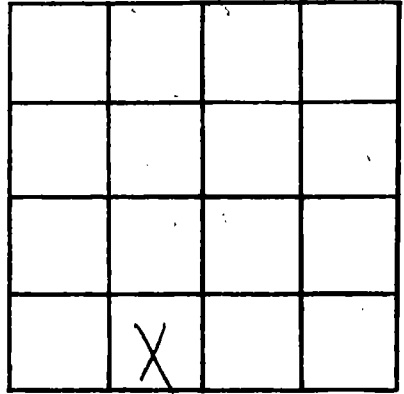

SECTION 19

Please indicate well location X.

ADDITIONAL INFORMATION

If more than one screen, show locations of each on sketch.