

MISSISSIPPI DEPARTMENT OF NATURAL RESOURCES
Bureau of Land and Water Resources
 Southport Mall
 P.O. Box 10631
 Jackson, Mississippi 39209
WATER WELL DRILLERS LOG

Harrison
0
2113

10-28, 1983 date well completed McGill Wells, Inc. firm name HARRISON county well located

LANDOWNER: RODRIGUE Goodman
Menap Avenue
Pass Ct., MS
 (mailing address)

description of formations encountered	from	to
<u>unred sand</u>	<u>0</u>	<u>3100</u>
	<u>red</u>	<u>4200</u>

WELL LOCATION:
 sec. 5 T. 8 N. R. 12 E
6 miles S of DB
 (distance) (direction) (nearest town)

WELL PURPOSE:
 (home, irrigation, municipal, industrial)

WELL COMPLETION DATA:

- (1) diameter (inches) 2"
- (2) total depth (feet) 420
- (3) static water level (feet) 30 below above top of ground.
- (4) casing 40 PUC, 410'
 (material) (depth)
 (size) If telescope see back.
- (5) screen 10', 410'
 (length) (depth to top)
2", 80 PUC 6 SLOT
 (size) (material)
- (6) pump 1 (HP) 12 (yield gpm)
EL.
 (type power)
- (7) electric log NO
 (yes or no)
 (organization running log)
- (8) how well bottom plugged SAND SEAL


DEPT. OF NATURAL RESOURCES
 BUREAU OF LAND & WATER RESOURCES

RECEIVED

DRILLERS REMARKS:

If well telescopes please sketch and show depths.

GROUND LEVEL

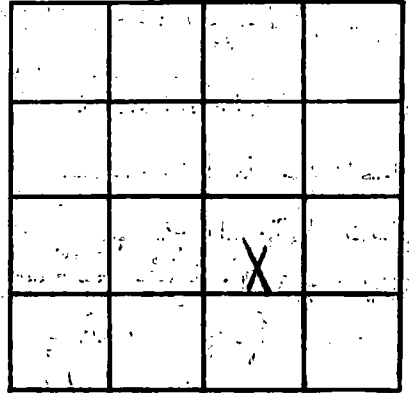

SECTION 5

Please indicate well location X.

ADDITIONAL INFORMATION

If more than one screen, show locations of each on sketch.