

MISSISSIPPI DEPARTMENT OF NATURAL RESOURCES
Bureau of Land and Water Resources
 Southport Mall
 P.O. Box 10631
 Jackson, Mississippi 39209
WATER WELL DRILLERS LOG

Harrison
0
2115

1-28-1984 date well completed McGill Wells, Inc. firm name HARRISON county well located

LANDOWNER: JOYCE SAELENS
RT 1, Box 190-A
Long Beach, Mo. 39560
 (mailing address)

description of formations encountered	from	to
	SAND	0
MUD	60	370
SAND	370	430

WELL LOCATION:
 sec. 9 T. 8 N. R. 12 E.
3 miles West of Long Beach
 (distance) (direction) (nearest town)

WELL PURPOSE: HOME
 (home, irrigation, municipal, industrial)

WELL COMPLETION DATA:

(1) diameter (inches) 2"

(2) total depth (feet) 430'

(3) static water level (feet) 70 below above top of ground.

(4) casing Sch 40 PVC 430'
 (material) (depth)

_____ (size) if telescope see back.

(5) screen 10', 430'
 (length) (depth to top)

2", Sch 80 PVC 165/10T
 (size) (material)

(6) pump 1 (HP) 8 (yield gpm)
electric
 (type power)

(7) electric log NO
 (yes or no)

_____ (organization running log)

(8) how well bottom plugged SAND
SEAL

DRILLERS REMARKS: _____


DEPT. OF NATURAL RESOURCES
 BUREAU OF LAND & WATER RESOURCES

MAR - 6 1984

RECEIVED

If well telescopes please sketch and show depths.

GROUND LEVEL

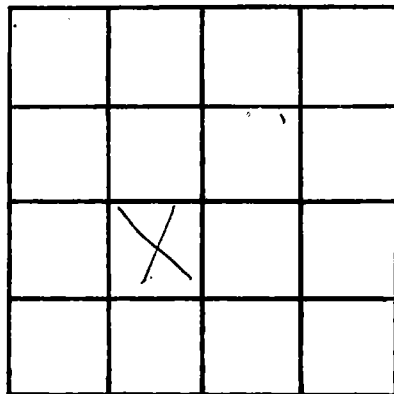

SECTION 9

Please indicate well location X.

ADDITIONAL INFORMATION

If more than one screen, show locations of each on sketch.