

MISSISSIPPI DEPARTMENT OF NATURAL RESOURCES

Bureau of Land and Water Resources

Southport Mall

P.O. Box 10631

Jackson, Mississippi 39209

WATER WELL DRILLERS LOG

Harrison
0
2117

3-21 1984 McGill Harrison
 date well completed firm name county well located

LANDOWNER: Harrie Ford
Larkwood Lane
Long Beach, Ms.
 (mailing address)

description of formations encountered	from	to
	<u>Sand</u>	<u>0</u>

WELL LOCATION:
 sec. 11 T. 8 N. R. 12 E.
2 miles N of LB
 (distance) (direction) (nearest town)

WELL PURPOSE: Drinking
 (home, irrigation, municipal, industrial)

WELL COMPLETION DATA:

(1) diameter (inches) 2"

(2) total depth (feet) 30

(3) static water level (feet) 5' ^(below) _{above} top of ground.

(4) casing Sch. 40 PVC 20'
 (material) (depth)
— (size) if telescope see back.

(5) screen 10' 30
 (length) (depth to top)
2" (size) Sch. 40 (material)

(6) pump 1/2 (HP) 9 (yield gpm)
electric (type power)

(7) electric log — (yes or no)
— (organization running log)

(8) how well bottom plugged Capped

DRILLERS REMARKS: _____


DEPT. OF NATURAL RESOURCES
 BUREAU OF LAND & WATER RESOURCES

APR - 5 1984

RECEIVED

If well telescopes please sketch and show depths.

GROUND LEVEL

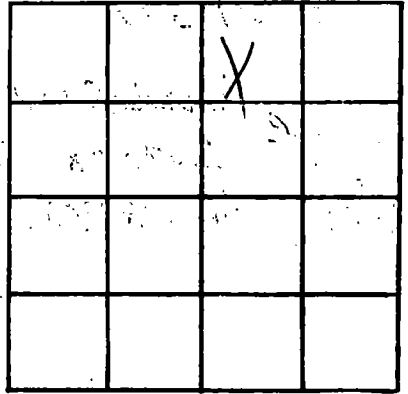

SECTION 11

Please indicate well location X.

ADDITIONAL INFORMATION

If more than one screen, show locations of each on sketch.