




If well telescopes please sketch and show depths.

GROUND LEVEL

shold beel mid: 77 10-17-84

50  
 055  
 050  
 045  
 040  
 035  
 030  
 025  
 020  
 015  
 010  
 005  
 000  
 005  
 010  
 015  
 020  
 025  
 030  
 035  
 040  
 045  
 050  
 055  
 060

sand  
 pump  
 sand  
 pump  
 sand  
 pump  
 sand

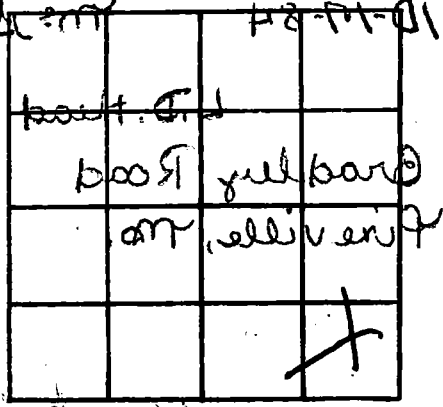

SECTION \_\_\_\_\_

Please indicate well location X.

ADDITIONAL INFORMATION

220  
 210  
 200  
If more than one screen, show locations of each on sketch.