

MISSISSIPPI DEPARTMENT OF NATURAL RESOURCES

Bureau of Land and Water Resources

Southport Mall

P.O. Box 10631

Jackson, Mississippi 39209

WATER WELL DRILLERS LOG
COASTAL DRILLING & SERVICE CO.

Harrison
D
2119

1/5/84 19
date well completed

ROUTE 1 BOX 618
firm name

BILOXI, MISS. 39532

Harrison
county well located

LANDOWNER

Thomas & Thana

description of formations encountered

from to

Coates Co.
Fory Beach, Ms
(mailing address)

<u>Top soil</u>	<u>1</u>	<u>3</u>
<u>white sand</u>	<u>3</u>	<u>18</u>
<u>gray sand</u>	<u>18</u>	<u>35</u>
<u>shale & shell</u>	<u>35</u>	<u>50</u>
<u>soft blue clay</u>	<u>50</u>	<u>240</u>
<u>fine white sand</u>	<u>240</u>	<u>260</u>
<u>hard blue clay</u>	<u>260</u>	<u>395</u>
<u>fine white sand</u>	<u>395</u>	<u>420</u>
<u>gray white sand</u>	<u>420</u>	<u>450</u>

WELL LOCATION:

sec. 2 T. 8 N. R. 12 E.
S. W.
Canal No. 3 of
(distance) (direction) (nearest town)

WELL PURPOSE: none
(home, irrigation, municipal, industrial)

WELL COMPLETION DATA:

- (1) diameter (inches) 2"
- (2) total depth (feet) 450'
- (3) static water level (feet) 42' below above top of ground.
- (4) casing PVC 450'
(material) (depth)
- (size) if telescope see back.
- (5) screen 10' 440'
(length) (depth to top)
- 2" PVC
(size) (material)
- (6) pump 1/2 62
(HP) (yield gpm)
- 3/4
(type power)
- (7) electric log no
(yes or no)


(organization running log)

(8) how well bottom plugged
2" (soft white) blue

DRILLERS REMARKS: 19-B

If well telescopes please sketch and show depths.

GROUND LEVEL

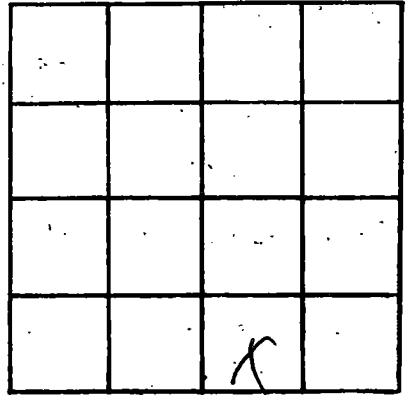

SECTION _____

Please indicate well location X.

ADDITIONAL INFORMATION

If more than one screen, show locations of each on sketch.