

MISSISSIPPI DEPARTMENT OF NATURAL RESOURCES

Bureau of Land and Water Resources

Southport Mall

P.O. Box 10631

Jackson, Mississippi 39209

WATER WELL DRILLERS LOG

HARRISON
 &
 2120

5-7 19 Mc Mill Well Harrison
 date well completed firm name county well located

LANDOWNER: Chris Caruba
Summer Lane
Long Beach, Mo
 (mailing address)

description of formations encountered	from	to
Mud	0	200
Mud	200	220
Sand	220	320
Mud	320	420
Mud & Sand	420	440

WELL LOCATION:
 sec. 11 T. 8 N R. 2 E
 S W
2 miles W of L.B
 (distance) (direction) (nearest town)

WELL PURPOSE:
~~(home)~~ irrigation, municipal, industrial)

WELL COMPLETION DATA:

(1) diameter (inches) 2"

(2) total depth (feet) 480'

(3) static water level (feet) 70 ^{below} ~~above~~ top of ground

(4) casing DCP 40 400'
 (material) (depth)

1
 (size) if telescope see back.

(5) screen 10' 400'
2' (length) (depth to top)
DCP 50
 (size) (material)

(6) pump 1 8
 (HP) (yield gpm)

1/2
 (type power)

(7) electric log yes
 (yes or no)

and Seal
 (organization running log)

(8) how well bottom plugged


DRILLERS REMARKS:

DEPT. OF NATURAL RESOURCES
 BUREAU OF LAND & WATER RESOURCES

JUL 10 1984
 RECEIVED

If well telescopes please sketch and show depths.

GROUND LEVEL

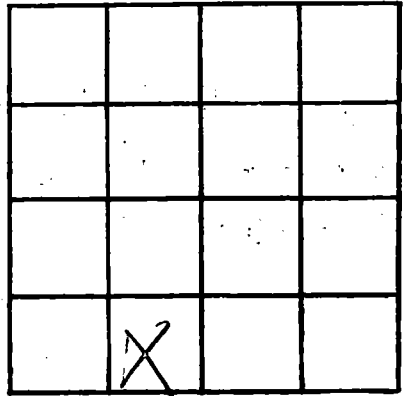

SECTION 11

Please indicate well location X.

ADDITIONAL INFORMATION

If more than one screen, show locations of each on sketch.