

MISSISSIPPI DEPARTMENT OF NATURAL RESOURCES
Bureau of Land and Water Resources
 Southport Mall
 P.O. Box 10631
 Jackson, Mississippi 39209
WATER WELL DRILLERS LOG

HARRISON
2
2121

6-23-84 19 84 McNeil Well Works Harrison
 date well completed firm name county well located

LANDOWNER: Stephen Morgan
724 Leich St.
Long Beach, Mo.
 (mailing address) 64501

description of formations encountered	depth	
	from	to
<u>Sand</u>	<u>0</u>	<u>220</u>
<u>mud</u>	<u>220</u>	<u>290</u>
<u>Sands mud</u>	<u>290</u>	<u>300</u>
<u>mud</u>	<u>300</u>	<u>320</u>
<u>Sand</u>	<u>320</u>	<u>520</u>

WELL LOCATION:
 sec. 11 T. 8 N. R. 12 E
 S W
6 miles S of Grpt
 (distance) (direction) (nearest town)

WELL PURPOSE: Home
 (home, irrigation, municipal, industrial)

WELL COMPLETION DATA:

- (1) diameter (inches) 2"
- (2) total depth (feet) 520'
- (3) static water level (feet) 20' ^{below} above top of ground
- (4) casing PVC 510'
 (material) (depth)
 (size) If telescope see back.
- (5) screen 10' 510'
 (length) (depth to top)
2" sch 80
 (size) (material)
- (6) pump 1 9
 (HP) (yield gpm)
elec
 (type power)
- (7) electric log
 (yes or no)
 (organization running log)
- (8) how well bottom plugged Seal

DRILLERS REMARKS: _____


DEPT. OF NATURAL RESOURCES
 BUREAU OF LAND & WATER RESOURCES

JUL 10 1984

RECEIVED

If well telescopes please sketch and show depths.

GROUND LEVEL

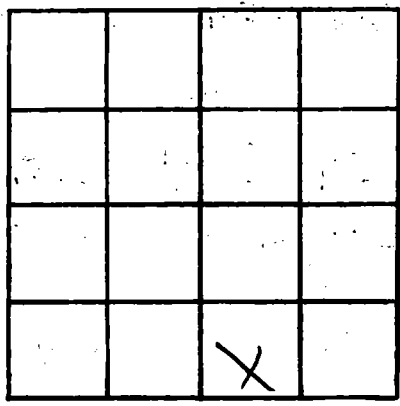

SECTION 11

Please indicate well location X.

ADDITIONAL INFORMATION

Multiple horizontal lines for writing additional information.

If more than one screen, show locations of each on sketch.