

MISSISSIPPI DEPARTMENT OF NATURAL RESOURCES

Bureau of Land and Water Resources

Southport Mall

P.O. Box 10631

Jackson, Mississippi 39209

WATER WELL DRILLERS LOG

CONSULTING ENGINEERS & SERVICE CO.

Harrison
Q 2123
6-5-84

6/5/84

date well completed

RT. 11, BOX 81

BLIXT name 30532

Harrison

county well located

LANDOWNER: Joe Stanbro Estate

Pass Christian, MS

(mailing address)

WELL LOCATION:

sec. 20 T. 8 N. R. 12 E
S W
Pass Christian
(distance) (direction) (nearest town)

WELL PURPOSE: industrial
(home, irrigation, municipal, industrial)

WELL COMPLETION DATA:

- (1) diameter (inches) 4 1/2"
- (2) total depth (feet) 630'
- (3) static water level (feet) 13' below top of ground.
- (4) casing PVC, 615',
(material) (depth)
4 1/2" If telescope see back.
(size)
- (5) screen 15', 615'
(length) (depth to top)
2", PVC
(size) (material)
- (6) pump 1 18-10
(HP) (yield gpm)
PVC
(type power)
- (7) electric log NO
(yes or no)

(organization running log)

(8) how well bottom plugged 2" back wash valve 170

DRILLERS REMARKS:

description of formations encountered	from	to
top soil	1	3
red clay	3	20
sugar sand	20	30
soft blue clay	30	140
hard blue clay	140	250
coarse white sand	250	280
red clay	280	310
hard blue clay	310	420
coarse black sand	420	435
soft blue clay	435	580
hard blue clay	580	610
fine water sand	610	620
good water sand	620	630

RECEIVED

JUL 22 1985

Department of Natural Resources
Bureau of Land & Water Resources

If well telescopes please sketch and show depths.

GROUND LEVEL


180' 4" pvc casing

450' 2" pvc casing

15' 2" pvc ^{screen} ~~casing~~

2' backwash valve

If more than one screen, show locations of each on sketch.

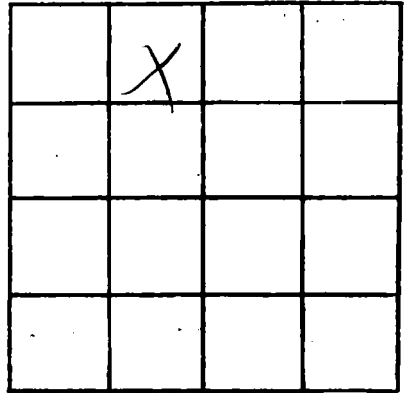

SECTION _____

Please indicate well location X.

ADDITIONAL INFORMATION

Multiple horizontal lines for additional information.