

MISSISSIPPI DEPARTMENT OF NATURAL RESOURCES

Bureau of Land and Water Resources

Southport Mall

P.O. Box 10631

Jackson, Mississippi 39209

WATER WELL DRILLERS LOG
COASTAL DRILLING & SERVICE CO.

Harrison
 2124
 6-5-84

6/3/84
 date well completed

RT. 11 BOX 01
 film name

Harrison
 county well located

LANDOWNER: Dee Starbuck
Pass Christian, MS
 (mailing address)

WELL LOCATION:
 soc. 20 T. 8 N. R. 12 E
Pass Christian
 (distance) (direction) (nearest town)

WELL PURPOSE: industrial
 (home, irrigation, municipal, industrial)

WELL COMPLETION DATA:

(1) diameter (inches) 4" x 2"

(2) total depth (feet) 630'

(3) static water level (feet) 15 below above top of ground.

(4) casing pvc, 615,
 (material) (depth)
4" x 2" if telescope see back.
 (size)

(5) screen 15, 615
 (length) (depth to top)
2", pvc
 (size) (material)

(6) pump 1, 189
 (HP) (yield gpm)
Elc.
 (type power)

(7) electric log NO
 (yes or no)
 (organization running log)

(8) how well bottom plugged 2" back
wash well 17-B

description of formations encountered	from	to
top soil	1	3
red clay	3	20
sugar sand	20	50
soft blue clay	50	140
hard blue clay	140	250
course white sand	250	280
red clay	280	310
hard blue clay	310	420
course white sand	420	455
soft blue clay	455	580
hard blue clay	580	610
fine water sand	610	620
good water sand	620	630

RECEIVED
 JUL 22 1985

DRILLERS REMARKS:

If well telescopes please sketch and show depths.


GROUND LEVEL

180' 4" pvc casing

450' 2" pvc casing

15' 2" pvc screen

2" back wash valve

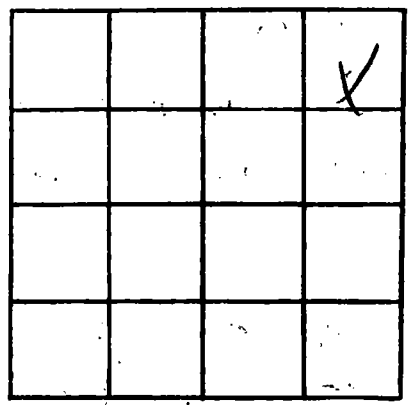

SECTION _____

Please indicate well location X.

ADDITIONAL INFORMATION

If more than one screen, show locations of each on sketch.