

MISSISSIPPI DEPARTMENT OF NATURAL RESOURCES

Bureau of Land and Water Resources

Southport Mall

P.O. Box 10631

Jackson, Mississippi 39209

WATER WELL DRILLERS LOG

COASTAL DRILLING & SERVICE CO. *Harrison*

*Harrison*  
 O 2130

*4/2/84*  
 date well completed

ROUTE # *BOX 618*

county well located

LANDOWNER: *Lee Stankard*

MISS 39532  
 description of formations encountered

from to

# *1* Job name  
*Jessie Christian Mrs*  
 (mailing address)

<i>Top Soil</i>	<i>1</i>	<i>3</i>
<i>Red Clay</i>	<i>3</i>	<i>10</i>
<i>Soft Blue Clay</i>	<i>10</i>	<i>170</i>
<i>fine water sand</i>	<i>170</i>	<i>200</i>
<i>Soft Blue Clay</i>	<i>200</i>	<i>275</i>
<i>hard Blue Clay</i>	<i>275</i>	<i>410</i>
<i>fine water sand</i>	<i>410</i>	<i>430</i>
<i>Hard Blue Clay</i>	<i>430</i>	<i>550</i>
<i>fine water sand</i>	<i>550</i>	<i>590</i>
<i>gravel water sand</i>	<i>590</i>	<i>630</i>

WELL LOCATION:

sec. *18* T. *S* N. R. *12* E  
 S W  
*Bayou Portage*  
 (distance) (direction) (nearest town)

WELL PURPOSE: *home*  
 (home, irrigation, municipal, industrial)

WELL COMPLETION DATA:

- (1) diameter (inches) *4 1/2"*
- (2) total depth (feet) *630'*
- (3) static water level (feet) *5'* below above top of ground.
- (4) casing *PVC* *615'*  
 (material) (depth)  
*4 1/2"* If telescope see back.  
 (size)
- (5) screen *15'* *615'*  
 (length) (depth to top)  
*2"* *PVC*  
 (size) (material)
- (6) pump *1 1/2 hp* *20*  
 (HP) (yield gpm)  
*Electric*  
 (type power)
- (7) electric log *No*  
 (yes or no)

(organization running log)

(8) how well bottom plugged  
*1 1/2 inch valve*  
 DRILLERS REMARKS: *19-B*

DEPT. OF NATURAL RESOURCES  
 BUREAU OF LAND & WATER RESOURCES


NOV 16 1984

RECEIVED

If well telescopes please sketch and show depths.

GROUND LEVEL

160'-4" PVC Casing

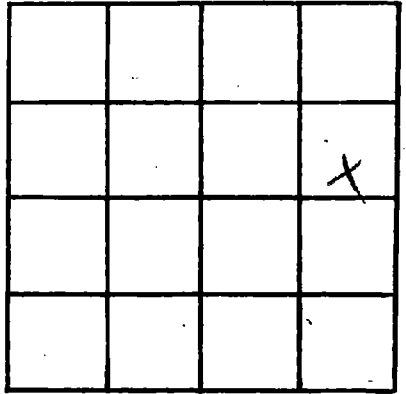

SECTION \_\_\_\_\_

Please indicate well location X.

ADDITIONAL INFORMATION

455'-2" PVC Casing

15'-2" PVC screen

1 ea 2" bod wall valve  
19-B

If more than one screen, show locations of each on sketch.