

MISSISSIPPI DEPARTMENT OF NATURAL RESOURCES

Bureau of Land and Water Resources

Southport Mall

P.O. Box 10631

Jackson, Mississippi 39209

WATER WELL DRILLERS LOG
COASTAL DRILLING & SERVICE CO.

Hanson
02131

4/19/84
Date well completed

ROUTE 1 BOX 618
Firm name

Harrison
county well located

LANDOWNER: W.R. Wallace

description of formations encountered

from to

James Ave
James Christian Jones
(mailing address)

<u>Topsoil</u>	<u>1</u>	<u>3</u>
<u>Red Clay</u>	<u>3</u>	<u>15</u>
<u>Soft Blue Clay</u>	<u>15</u>	<u>160</u>
<u>Fine Water Sand</u>	<u>160</u>	<u>180</u>
<u>Soft Blue Clay</u>	<u>180</u>	<u>275</u>
<u>Hard Blue Clay</u>	<u>275</u>	<u>400</u>
<u>Fine Water Sand</u>	<u>400</u>	<u>420</u>
<u>Hard Blue Clay</u>	<u>420</u>	<u>670</u>
<u>Fine Water Sand</u>	<u>590</u>	<u>600</u>
<u>SD water Sand</u>	<u>600</u>	<u>640</u>

WELL LOCATION:

sec. 16 T. S N. R. 12E W.

Bayou (distance) Postage (direction) (nearest town)

WELL PURPOSE: home
(home, irrigation, municipal, industrial)

WELL COMPLETION DATA:

- (1) diameter (inches) 4 1/2"
- (2) total depth (feet) 640'
- (3) static water level (feet) 61' below above top of ground.
- (4) casing PC (material) 625' (depth)
4 1/2" (size) If telescope see back.
- (5) screen 15' (length) 625' (depth to top)
2" (size) PC (material)
- (6) pump None (HP) 20 (yield gpm)
Ele (type power)
- (7) electric log no (yes or no)

(organization running log)

(8) how well bottom plugged

2' Reddish Yellow
DRILLERS REMARKS: 19-8

DEPT. OF NATURAL RESOURCES
BUREAU OF LAND & WATER RESOURCES


NOV 16 1984

RECEIVED

If well telescopes please sketch and show depths.

GROUND LEVEL

200'-4" PVC Casing

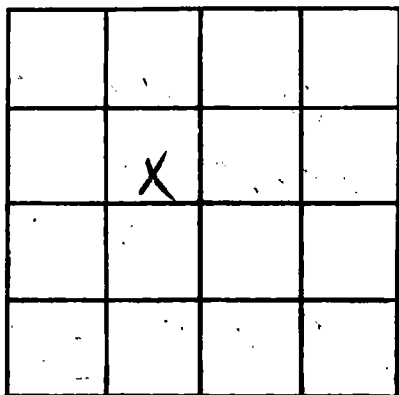

SECTION _____

Please indicate well location X.

ADDITIONAL INFORMATION

425'-2" PVC Casing

15'-2" PVC Screen

2" back wash valve
19-B

If more than one screen,
show locations of each on sketch.