

MISSISSIPPI DEPARTMENT OF NATURAL RESOURCES

Bureau of Land and Water Resources

Southport Mall

P.O. Box 10631

Jackson, Mississippi 39209

WATER WELL DRILLERS LOG  
COASTAL DRILLING & SERVICE CO.

Harrison  
Q 2134  
2-5-85

2/5/85  
date well completed

RT 11, BOX 81  
firm name

Harrison  
county well located

LANDOWNER: Steve P. Peck  
14 Evangeline Drive  
Pass Christian, MS  
(mailing address)

WELL LOCATION:  
sec. 19 T. 8 N. R. 12 E.  
S. W.  
Pass Christian  
miles (distance) direction (nearest town)

WELL PURPOSE: home  
(home, irrigation, municipal, industrial)

- WELL COMPLETION DATA:
- (1) diameter (inches) 2"
  - (2) total depth (feet) 600
  - (3) static water level (feet) 10 below above top of ground.
  - (4) casing pvc, 590,  
(material) (depth)  
         if telescope see back.  
(size)
  - (5) screen 10', 590  
(length) (depth to top)  
2", pvc  
(size) (material)
  - (6) pump 1, 10  
(HP) (yield gpm)  
etc.  
(type power)
  - (7) electric log NO  
(yes or no)  
          
(organization running log)
  - (8) how well bottom plugged 2" back  
wash valve 19-B

description of formations encountered	from	to
top soil	1	5
sugar sand	5	25
red clay	25	160
fine water sand	160	180
hard blue clay	180	290
soft blue clay	290	380
fine water sand	380	410
red clay	410	580
fine water sand	580	590
toped water sand	590	600

RECEIVED


JUL 25 1985

DRILLERS REMARKS:

Department of Natural Resources  
Bureau of Land & Water Resources

If well telescopes please sketch and show depths.

GROUND LEVEL

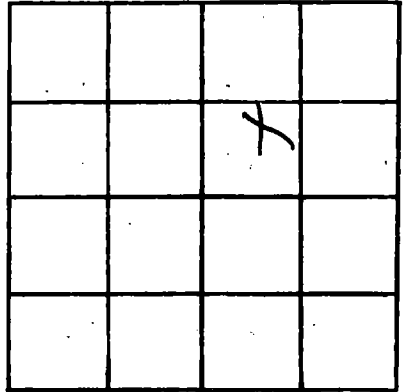

SECTION \_\_\_\_\_

Please indicate well location X.

ADDITIONAL INFORMATION

If more than one screen,  
show locations of each on sketch.