

Harrison
 Q 2137
 5-6-85

MISSISSIPPI DEPARTMENT OF NATURAL RESOURCES
 Bureau of Land and Water Resources
 Southport Mall
 P.O. Box 10631
 Jackson, Mississippi 39209
WATER WELL DRILLERS LOG

L

5-6-1985 date well completed
 85 Ward Well Dlg. firm name
 Harrison county well located

LANDOWNER:

Eugene Fortusby

description of formations encountered

from to

Lot A - Gardenia St.
 Pass Christian, miss.
 (mailing address)

Clay 0 26
 Clay SC 26 54
 Clay - Silt 54 165
 Silt 165 188
 Clay - Silt 188 258
 Silt 258 294

WELL LOCATION:

sec. 7 T 8 N R 13 E
 12 miles N/E of P.C.
 (distance) (direction) (nearest town)

WELL PURPOSE:

Home (home, irrigation, municipal, industrial)

WELL COMPLETION DATA:


- (1) diameter (inches) 2"
- (2) total depth (feet) 294
- (3) static water level (feet) 3 below top of ground
- (4) casing PVC, 284 (material) (depth)
- (size) if telescope see back.
- (5) screen 10' (length) (depth to top)
- 2" PVC (size) (material)
- (6) pump none (HP) (yield gpm)
- (type power)
- (7) electric log NO (yes or no)
- N/A (organization running log)
- (8) how well bottom plugged BWU

RECEIVED
 JUL 12 1985

DRILLERS REMARKS: N/A

If well telescopes please sketch and show depths.

GROUND LEVEL

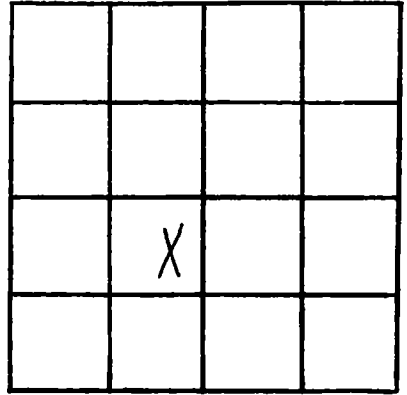

SECTION 7

Please indicate well location X.

ADDITIONAL INFORMATION

If more than one screen, show locations of each on sketch.