

MISSISSIPPI DEPARTMENT OF NATURAL RESOURCES

Bureau of Land and Water Resources

Southport Mall

P.O. Box 10631

Jackson, Mississippi 39209

WATER WELL DRILLERS LOG

HARRISON
Q 2138

5/16/85
date well completed

Lyman Well Co.
firm name

Harrison
county well located

LANDOWNER: Gregory F. Ladner
105 La Rosa Rd.
Long Beach, Ms 39560
(mailing address)

Description of formations encountered	from	to
sand fine	0	20
white clay	20	60
gray clay	60	140
SAND coarse	140	150

WELL LOCATION:

sec. 11 T. 8 N R. 12 E
2 miles north of Long Beach
(distance) (direction) (nearest town)

WELL PURPOSE:

(home, irrigation, municipal, industrial)

WELL COMPLETION DATA:

- (1) diameter (inches) 2"
- (2) total depth (feet) 150'
- (3) static water level (feet) 20' below top of ground.
- (4) casing PVC 140' (material) (depth)
- (size) 2" If telescope see back.
- (5) screen 10' 140' (length) (depth to top)
- (size) 2" (material) PVC
- (6) pump N/A 10 (type power) (yield gpm)
- Electric
- (7) electric log No (yes or no)
- NO (organization running log)
- (8) how well bottom plugged Sand Shark


DRILLERS REMARKS:

Department of Natural Resources
Bureau of Land & Water Resources

AUG 20 1985

If well telescopes please sketch and show depths.

GROUND LEVEL

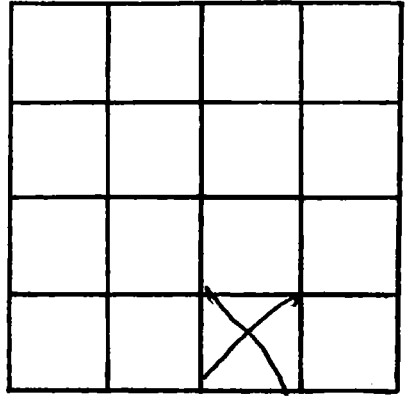

SECTION 11

Please indicate well location X.

ADDITIONAL INFORMATION

If more than one screen,
show locations of each on sketch.