

MISSISSIPPI DEPARTMENT OF NATURAL RESOURCES

Bureau of Land and Water Resources

Southport Mall

P.O. Box 10631

Jackson, Mississippi 39209

WATER WELL DRILLERS LOG

Harrison
D. 2139
5-6-85

5-6 1985 Mc Hill Well Works Harrison
 date well completed firm name county well located

LANDOWNER: Necresse
Construction
 (mailing address)
 WELL LOCATION:
 sec. 21 T. 8 N R. 12 E
5 miles W of Long Beach
 (distance) (direction) (nearest town)

WELL PURPOSE:
 (home, irrigation, municipal, industrial)

WELL COMPLETION DATA:
 (1) diameter (inches) 2"
 (2) total depth (feet) 580'
 (3) static water level (feet) 40' below above top of ground.
 (4) casing 4" Sch 40 570'
 (material) (depth)
 (size) if telescope see back.
 (5) screen 10' 570'
 (length) (depth to top)
2" Sch 80 6 slot
 (size) (material)
 (6) pump 1 8
 (HP) (yield gpm)
Elec
 (type power)
 (7) electric log _____
 (yes or no)
 (organization running log)
 (8) how well bottom plugged SAND
SHARK

description of formations encountered	from	to
Mud	0	20
Mud/Sand/Gravel	20	40
Sand/Gravel/mud	40	60
Mud	60	100
Mud/Sand	100	120
Mud	120	140
Mud/Sand	140	180
Sand/mud	180	200
Mud	200	240
Sand	240	260
Mud	260	500
Mud/Sand	500	520
Mud/Sand	520	540
Sand	540	580


RECEIVED
 JUN 11 1985

Department of Natural Resources
 Bureau of Land & Water Resources

DRILLERS REMARKS:

If well telescopes please sketch and show depths.

GROUND LEVEL

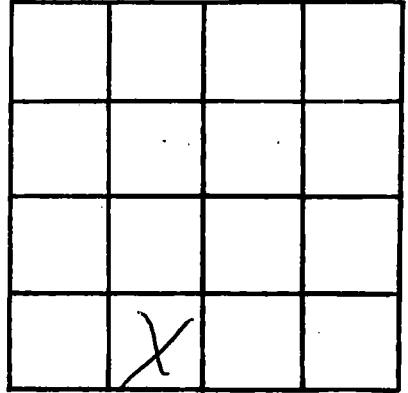

SECTION _____

Please indicate well location X.

ADDITIONAL INFORMATION

If more than one screen,
show locations of each on sketch.