

MISSISSIPPI DEPARTMENT OF NATURAL RESOURCES

Bureau of Land and Water Resources

Southport Mall

P.O. Box 10631

Jackson, Mississippi 39209

WATER WELL DRILLERS LOG

Harrison
 2141
 6-28-85

6-28-85
 date well completed

R. T. Mooke
 firm name

HARRISON
 county well located


LANDOWNER: <u>W. R. SEVTON</u> <u>ARCADIA RD</u>	description of formations encountered	from	to
<u>PASS CHRISTIAN MS</u> (mailing address)	<u>TOP SOIL</u>	<u>0</u>	<u>20</u>
WELL LOCATION: sec. <u>7</u> T. <u>8</u> N. R. <u>12</u> E. <u>1/4</u> miles <u>W</u> of <u>Pinhook</u> (distance) (direction) (nearest town)	<u>fine sand</u>	<u>20</u>	<u>60</u>
WELL PURPOSE: (home irrigation, municipal, industrial)	<u>clay</u>	<u>60</u>	<u>400</u>
WELL COMPLETION DATA: (1) diameter (inches) <u>2"</u>	<u>med sand</u>	<u>400</u>	<u>400</u>
(2) total depth (feet) <u>600'</u>	<u>clay</u>	<u>400</u>	<u>570</u>
(3) static water level (feet) <u>2'</u> <u>below</u> above top of ground.	<u>fine sand</u>	<u>570</u>	<u>580</u>
(4) casing <u>Pvc</u> , <u>600'</u> (material) (depth)	<u>clay</u>	<u>560</u>	<u>570</u>
(5) screen <u>10'</u> , <u>600'</u> (length) (depth to top)	<u>coarse sand</u>	<u>570</u>	<u>660</u>
(6) pump <u>1</u> , <u>10</u> (HP) (yield gpm)			
<u>E</u> (type power)			
(7) electric log <u>yes or no</u>			
<u> </u> (organization running log)			
(8) how well bottom plugged <u>Pvc</u>			
DRILLERS REMARKS:			

RECEIVED
 JUL 2 - 1985

Department of Natural Resources
 Bureau of Land & Water Resources

If well telescopes please sketch and show depths.

GROUND LEVEL

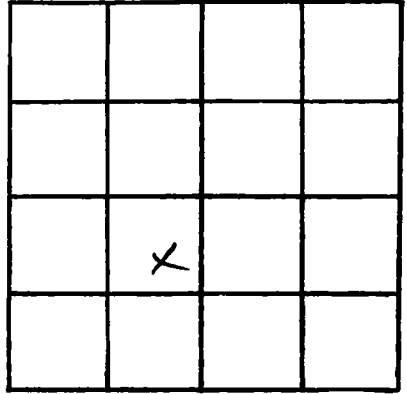

SECTION 2

Please indicate well location X.

ADDITIONAL INFORMATION

If more than one screen, show locations of each on sketch.