

HARRISON
 & 2142

MISSISSIPPI DEPARTMENT OF NATURAL RESOURCES
 Bureau of Land and Water Resources
 Southport Mall
 P.O. Box 10631
 Jackson, Mississippi 39209
WATER WELL DRILLERS LOG

6-12-1985 date well completed
 McNeil Pump & Well firm name
 Harrison county well located

LANDOWNER: Capt. Donald Demery
 425 East Beach
 Pass Christian, Ms. 39571
 (mailing address)

Description of formations encountered	from	to
Med / Sand	0	40
Sand	40	60

WELL LOCATION:
 sec. 20 T. 8 N. R. 12 E.
 (S) (W)
 1 miles W of Pass Christian
 (distance) (direction) (nearest town)

WELL PURPOSE:
 (home, irrigation, municipal, industrial)

WELL COMPLETION DATA:

(1) diameter (inches) 2"
 (2) total depth (feet) 60'
 (3) static water level (feet) 6' below top of ground.
 (4) casing Sch 40 PVC 50' (material) (depth)
 (size) if telescope see back.
 (5) screen 10' 50' (length) (depth to top)
 2" Sch 80 PVC (size) (material)
 (6) pump 1/2 HP 12 (yield gpm)
 Elect. (type power)
 (7) electric log (yes or no)
 (organization running log)
 (8) how well bottom plugged SAND SHARK


DRILLERS REMARKS:

RECEIVED
 JUL 8 - 1985

Department of Natural Resources
 Bureau of Land & Water Resources

If well telescopes please sketch and show depths.

GROUND LEVEL

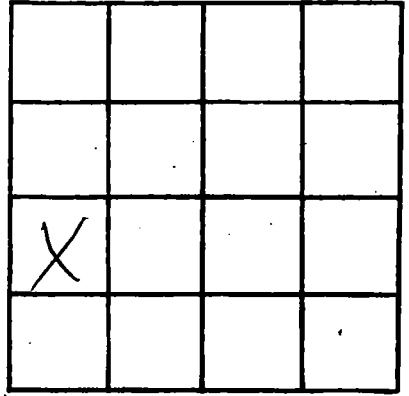

SECTION _____

Please indicate well location X.

ADDITIONAL INFORMATION

A series of horizontal lines for writing additional information, starting below the 'ADDITIONAL INFORMATION' header and extending to the bottom of the page.

If more than one screen, show locations of each on sketch.